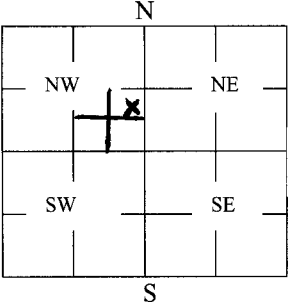


## WATER WELL PLUGGING RECORD Form WWC-5P

KSA 82a-1212 ID NO.

<b>1 LOCATION OF WATER WELL:</b> County: <u>WYANDOTTE</u> Fraction: <u>NE 1/4 SE 1/4 NW 1/4</u> Section Number: <u>13</u> Township Number: <u>11</u> Range Number: <u>24</u> <u>E/W</u> Distance and direction from nearest town or city street address of well if located within city? <u>730 FT. NORTH AND 350 FT. WEST OF THE INTERSECTION OF 51<sup>ST</sup> STREET AND SPEAKER ROAD, KANSAS CITY, KS. 66106</u>	<b>2 WATER WELL OWNER:</b> <u>HARCROS CHEMICALS INC.</u> RR#, St. Address, Box #: <u>5200 SPEAKER ROAD.</u> City, State ZIP Code: <u>KANSAS CITY KS 66106</u>	Global Positioning Systems (decimal degrees, min. of 4 digits) Latitude: <u>39.096914</u> Longitude: <u>-94.697215</u> Elevation: <u>766 ft.</u> Datum: <u>MSL</u> Data Collection Method: <u>IMAGE ATLAS WEBSITE</u>	
<b>3 MARK WELL'S LOCATION WITH AN "X" IN SECTION BOX:</b> <div style="text-align: center;">  </div>	<b>4 DEPTH OF WELL</b> <u>82</u> ft. WELL'S STATIC WATER LEVEL <u>46.5</u> ft. WELL WAS USED AS: <table style="width:100%;"> <tr> <td>1 Domestic</td> <td>5 Public Water Supply</td> <td>9 Dewatering</td> </tr> <tr> <td>2 Irrigation</td> <td>6 Oil Field Water Supply</td> <td>10 Monitoring</td> </tr> <tr> <td>3 Feedlot</td> <td>7 Domestic (Lawn &amp; Garden)</td> <td>11 Injection Well</td> </tr> <tr> <td><input checked="" type="radio"/> 4 Industrial</td> <td>8 Air Conditioning</td> <td>12 Other _____</td> </tr> </table> Was a chemical/bacteriological sample submitted to Department? Yes _____ No <input checked="" type="checkbox"/>		1 Domestic	5 Public Water Supply	9 Dewatering	2 Irrigation	6 Oil Field Water Supply	10 Monitoring	3 Feedlot	7 Domestic (Lawn & Garden)	11 Injection Well	<input checked="" type="radio"/> 4 Industrial	8 Air Conditioning	12 Other _____	
1 Domestic	5 Public Water Supply	9 Dewatering	
2 Irrigation	6 Oil Field Water Supply	10 Monitoring	
3 Feedlot	7 Domestic (Lawn & Garden)	11 Injection Well	
<input checked="" type="radio"/> 4 Industrial	8 Air Conditioning	12 Other _____	
<b>5 TYPE OF BLANK CASING USED:</b> <u>COPY OF ORIGINAL WELL CONSTRUCTION DRAWING ATTACHED FOR REFERENCE.</u> <table style="width:100%;"> <tr> <td>1 Steel</td> <td>3 RMP (SR)</td> <td>5 Wrought</td> <td>7 Fiberglass</td> <td>9 Other (Specify below)</td> </tr> <tr> <td>2 PVC</td> <td>4 ABS</td> <td>6 Asbestos-Cement</td> <td>8 Concrete Tile</td> <td></td> </tr> </table> Blank casing diameter _____ in. Was casing pulled? Yes _____ No _____ If yes, how much _____ Casing height above or below land surface _____ in.			1 Steel	3 RMP (SR)	5 Wrought	7 Fiberglass	9 Other (Specify below)	2 PVC	4 ABS	6 Asbestos-Cement	8 Concrete Tile	
1 Steel	3 RMP (SR)	5 Wrought	7 Fiberglass	9 Other (Specify below)	
2 PVC	4 ABS	6 Asbestos-Cement	8 Concrete Tile	
<b>6 GROUT PLUG MATERIAL:</b> <input checked="" type="radio"/> 1 Neat cement    2 Cement grout    3 Bentonite    4 Other _____ Grout Plug Intervals: From <u>42</u> ft. to <u>10</u> ft., From _____ ft. to _____ ft., From _____ to _____ ft. What is the nearest source of possible contamination: <u>WELL IS LOCATED ON HARCROS CHEMICALS INDUSTRY. HARCROS IS AN OPERATING CHEMICALS MANUFACTURING AND STORAGE FACILITY. SURROUNDED.</u> <table style="width:100%;"> <tr> <td>1 Septic tank</td> <td>6 Seepage pit</td> <td>11 Fuel Storage</td> </tr> <tr> <td>2 Sewer lines</td> <td>7 Pit privy</td> <td>12 Fertilizer storage</td> </tr> <tr> <td>3 Watertight sewer lines</td> <td>8 Sewage lagoon</td> <td>13 Insecticide storage</td> </tr> <tr> <td>4 Lateral lines</td> <td>9 Feedyard</td> <td>14 Abandoned water well</td> </tr> <tr> <td>5 Cess pool</td> <td>10 Livestock pens</td> <td>15 Oil well/Gas well</td> </tr> </table> Direction from well? _____ How many feet? <u>500 TO 700 FT.</u>			1 Septic tank	6 Seepage pit	11 Fuel Storage	2 Sewer lines	7 Pit privy	12 Fertilizer storage	3 Watertight sewer lines	8 Sewage lagoon	13 Insecticide storage	4 Lateral lines	9 Feedyard	14 Abandoned water well	5 Cess pool	10 Livestock pens	15 Oil well/Gas well																																							
1 Septic tank	6 Seepage pit	11 Fuel Storage	
2 Sewer lines	7 Pit privy	12 Fertilizer storage	
3 Watertight sewer lines	8 Sewage lagoon	13 Insecticide storage	
4 Lateral lines	9 Feedyard	14 Abandoned water well	
5 Cess pool	10 Livestock pens	15 Oil well/Gas well	
<table border="1" style="width:100%; border-collapse: collapse;"> <thead> <tr> <th>FROM</th> <th>TO</th> <th>PLUGGING MATERIALS</th> <th>FROM</th> <th>TO</th> <th>PLUGGING MATERIALS</th> </tr> </thead> <tbody> <tr> <td><u>82'</u></td> <td><u>42'</u></td> <td><u>WASHED GRAVEL (1/2" x 3/4")</u></td> <td></td> <td></td> <td></td> </tr> <tr> <td><u>42'</u></td> <td><u>10'</u></td> <td><u>NEAT CEMENT</u></td> <td></td> <td></td> <td></td> </tr> <tr> <td><u>10'</u></td> <td><u>6'</u></td> <td><u>4' DIA. SONATUBE W/ 4000# CONCRETE, 4' HIGH</u></td> <td></td> <td></td> <td></td> </tr> <tr> <td><u>6'</u></td> <td><u>0'</u></td> <td><u>BACKFILL NATIVE SOILS.</u></td> <td></td> <td></td> <td></td> </tr> <tr><td> </td><td> </td><td> </td><td> </td><td> </td><td> </td></tr> <tr><td> </td><td> </td><td> </td><td> </td><td> </td><td> </td></tr> <tr><td> </td><td> </td><td> </td><td> </td><td> </td><td> </td></tr> <tr><td> </td><td> </td><td> </td><td> </td><td> </td><td> </td></tr> </tbody> </table>			FROM	TO	PLUGGING MATERIALS	FROM	TO	PLUGGING MATERIALS	<u>82'</u>	<u>42'</u>	<u>WASHED GRAVEL (1/2" x 3/4")</u>				<u>42'</u>	<u>10'</u>	<u>NEAT CEMENT</u>				<u>10'</u>	<u>6'</u>	<u>4' DIA. SONATUBE W/ 4000# CONCRETE, 4' HIGH</u>				<u>6'</u>	<u>0'</u>	<u>BACKFILL NATIVE SOILS.</u>																											
FROM	TO	PLUGGING MATERIALS	FROM	TO	PLUGGING MATERIALS	
<u>82'</u>	<u>42'</u>	<u>WASHED GRAVEL (1/2" x 3/4")</u>	
<u>42'</u>	<u>10'</u>	<u>NEAT CEMENT</u>	
<u>10'</u>	<u>6'</u>	<u>4' DIA. SONATUBE W/ 4000# CONCRETE, 4' HIGH</u>	
<u>6'</u>	<u>0'</u>	<u>BACKFILL NATIVE SOILS.</u>	
<b>NOTE: WELL CLOSURE WAS COMPLETED BY JEFF JOSLYN, AQUADRILL (LICENSE #570) AND RON KLEMONICH, P.E. APTOS ENGINEERING GROUP INC.</b> <b>7 CONTRACTOR'S OR LANDOWNER'S CERTIFICATION:</b> This water well was plugged under my jurisdiction and was completed on (mo/day/year) <u>12/20/06</u> and this record is true to the best of my knowledge and belief. Kansas Water Well Contractor's License No. <u>570</u> . This Water Well Record was completed on (mo/day/year) <u>2/2/07</u> under the business name of <u>APTOS ENGINEERING GROUP, INC.</u> by (signature) <u>Ron Klemovich, P.E.</u>	
<b>INSTRUCTIONS:</b> Use typewriter or ballpoint pen. Please press firmly and print clearly. Please fill in blanks, underline or circle the correct answers. Send top three copies to Kansas Department of Health and Environment, Bureau of Water, Geology Section, 1000 SW Jackson St., Ste. 420, Topeka, Kansas 66612-1367. Telephone: 785/296-5522. Send one to Water Well Owner and retain one for your records. Visit us at <a href="http://www.kdheks.gov/geo/waterwells">http://www.kdheks.gov/geo/waterwells</a> .	

# Harcros Chemicals Inc. - Water Well # 6 - Plugging Record Photos

5200 Speaker Road, Kansas City, KS 66106

Water Right File Number: 38069-00



Harcros South Well # 6 - Pump pedestal and concrete base prior to well plugging activities



Harcros Well # 6 - exposed 18" well casing after removing pump and prior to cutting casing



Harcros Well # 6 - Sona-Tube Form over top of cut off well casing. Neat cement placed in well at this time.



Harcros Well # 6 - Sona-Tube Form filled with concrete prior to backfill.




Former Location Harcros Well # 6, finish grading

Aptos Engineering Group, Inc.  
Ronald M. Klemovich, P.E.  
February 6, 2007

CONSTRUCTION OF WELL

224

Thompson-Hayward Well #6

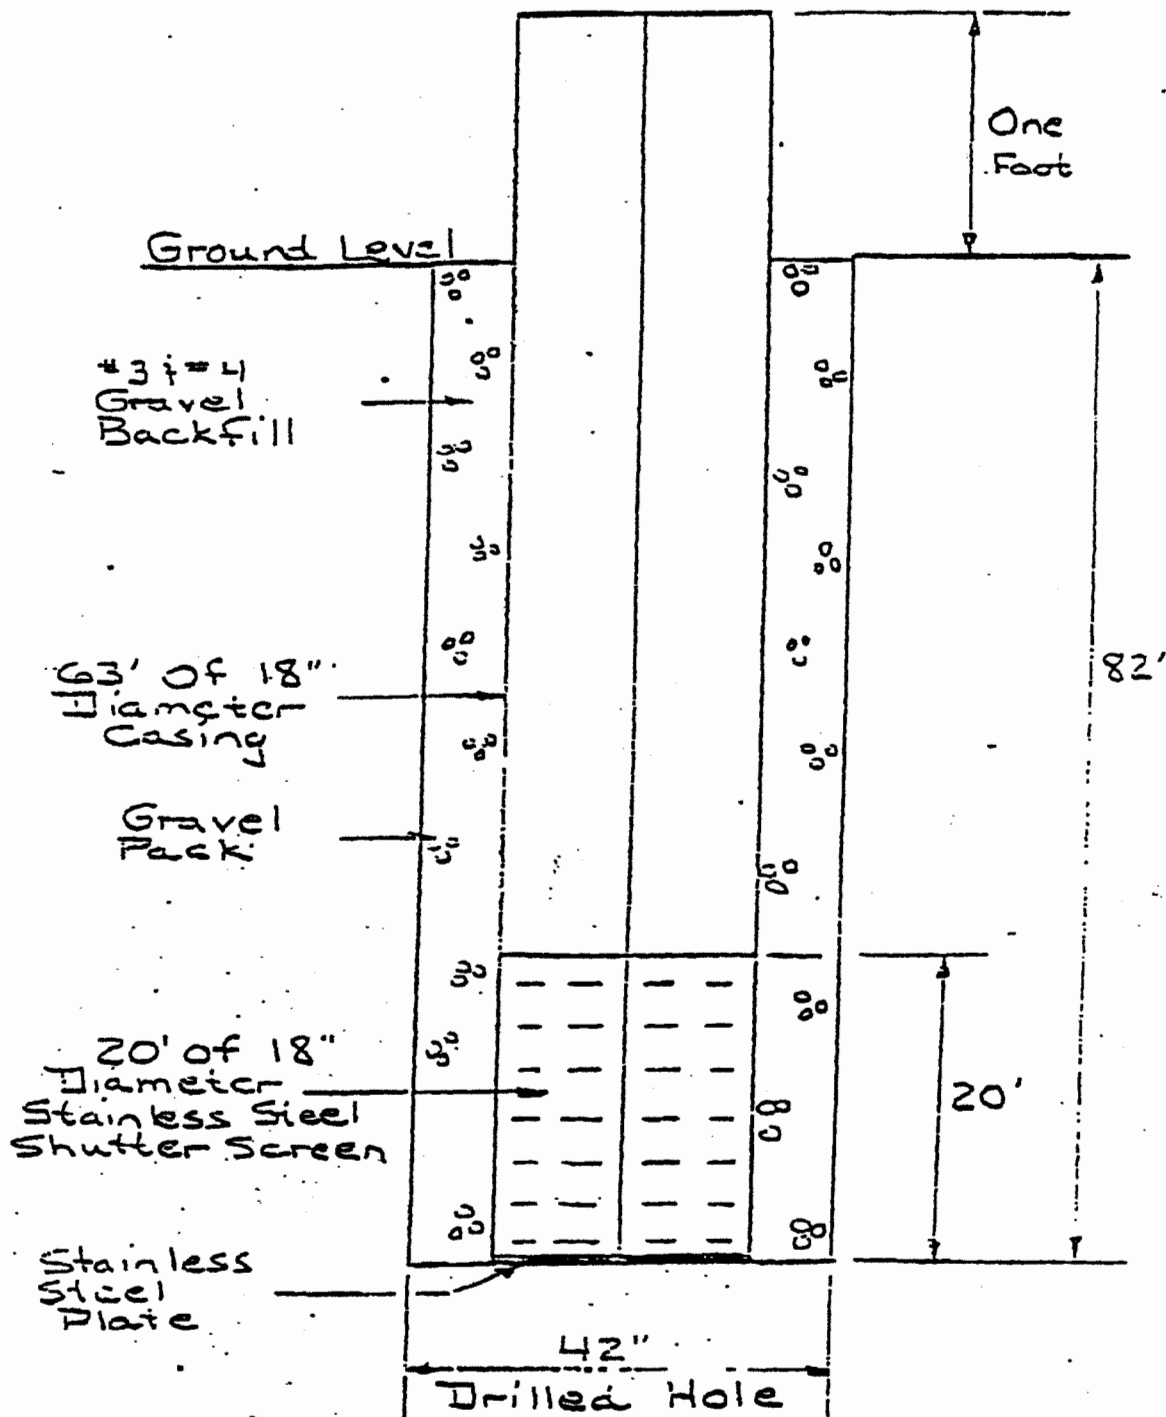

HARCROS CHEMICALS INC.  
5200 SPEAKER ROAD.  
KANSAS CITY, KS 66106

"PRIMARY" SOUTH WELL.  
WELL DRILLED BY:  
LAYNE WESTERN COMPANY.  
DECEMBER 1971