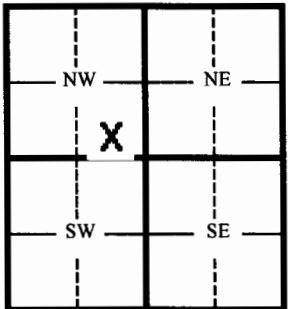


1 LOCATION OF WATER WELL:	Fraction	Section Number	Township Number	Range Number
County: Wyandotte	SE 1/4 SE 1/4 NW 1/4	5	11	24-East

Distance and direction from nearest town or city street address of well if located within city?

1700 N. 82nd Street, Kansas City, Kansas

2 WATER WELL OWNER: Alex R. Masson	Board of Agriculture, Division of Water Resources
RR#, St. Address, Box # P.O. Box 170	Application Number:
City, State, ZIP Code : Linwood, Kansas 66052	

3 MARK WELL'S LOCATION WITH AN "X" IN SECTION BOX:	4 DEPTH OF WELL 20.0 ft.												
<div style="text-align: center;">N W  E S</div>	WELL'S STATIC WATER LEVEL 14.28 ft.												
	WELL WAS USED AS:												
	<table><tr><td>1 Domestic</td><td>5 Public Water Supply</td><td>9 Dewatering</td></tr><tr><td>2 Irrigation</td><td>6 Oil Field Water Supply</td><td>10 Monitoring Well</td></tr><tr><td>3 Feedlot</td><td>7 Lawn and Garden (domestic)</td><td>11 Injection Well</td></tr><tr><td>4 Industrial</td><td>8 Air Conditioning</td><td>12 Other</td></tr>
	Was a chemical/bacteriological sample submitted to Department? Yes ___ No X												
	If yes, mo/day/yr sample was submitted _____												
	Water Well Disinfected: Yes ___ No X												

5 TYPE OF BLANK CASING USED:	1 Steel	3 RMP (SR)	5 Wrought	7 Fiberglass	9 Other (specify below)
	2 PVC	4 ABC	6 Asbestos-Cement	8 Concrete Tile	
Blank casing diameter 2.375 in.	Was casing pulled? Yes ___ No X	If yes, how much? N/A			
Casing height above or below land surface Unknown in.	Casing plugged; casing removed to depth of 3' BTOC.				


6 GROUT PLUG MATERIAL:	1 Neat cement	2 Cement grout	3 Bentonite	4 Other	Soils
Grout Plug Intervals	From 20.0 ft. to 3.0 ft.	From 3.0 ft. to 0.0 ft.	From ___ ft. to ___ ft.	From ___ ft. to ___ ft.	

What is the nearest source of possible contamination:

- | | | | |
|--------------------------|-------------------|--------------------------|--------------------------|
| 1 Septic tank | 6 Seepage pit | 11 Fuel storage (former) | 16 Other (specify below) |
| 2 Sewer lines | 7 Pit privy | 12 Fertilizer storage | |
| 3 Watertight sewer lines | 8 Sewage lagoon | 13 Insecticide storage | |
| 4 Lateral lines | 9 Feedyard | 14 Abandoned water well | |
| 5 Cess Pool | 10 Livestock pens | 15 Oil well/ Gas well | |

Direction from well? **West** How many feet? **90**

FROM	TO	CODE	PLUGGING MATERIALS
0.0	3.0		Compacted soils
3.0	20.0		Bentonite chips

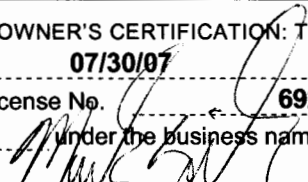7 CONTRACTOR'S OR LANDOWNER'S CERTIFICATION: This water well was plugged under my jurisdiction and was completed on (mo/day/yr) 07/30/07 and this record is true to the best of my knowledge and belief. Kansas Water Well Contractor's License No. 692 This Water Well Record was completed on (mo/day/yr) 09/21/07 under the business name of Quad State Services, Inc.
by (signature) 

INSTRUCTIONS: Please fill in blanks and circle the correct answers. Send three copies to Kansas Department of Health and Environment, Bureau of Water, 1000 S W Jackson St., Ste. 420, Topeka, Kansas 66620-0001. Telephone: 785-296-3565. Send one to Water Well Owner and retain one for your records.