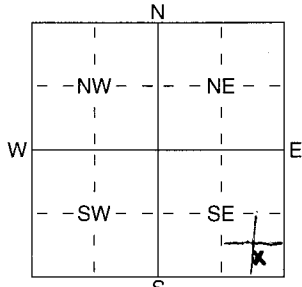


1 LOCATION OF WATER WELL: Fraction SE 1/4 SE 1/4 SE 1/4 Section Number 11 Township Number T 11 S Range Number R 24 E W
 County: WYANDOTTE

Distance and direction from nearest town or city street address of well if located within city? (I-70 & 57th St.) NEAR 5525 KAW DR., KANSAS CITY, KS 66102 LAT: N39°6'11.9"
 LONG: W94°42'24.8"

2 WATER WELL OWNER: CONOCO PHILLIPS Board of Agriculture, Division of Water Resources
 RR#, St. Address, Box # : 1360 PHILLIPS BLDG. Application Number:
 City, State, ZIP Code : BARTLESVILLE, OK 74004 (918-661-3616)

3 LOCATE WELL'S LOCATION WITH AN "X" IN SECTION BOX:  4 DEPTH OF COMPLETED WELL 38 ft. ELEVATION: ft.
 Depth(s) Groundwater Encountered 1 ft. 2 ft. 3 ft.
 WELL'S STATIC WATER LEVEL 32.8 ft. below land surface measured on mo/day/yr 4/23/09
 Pump test data: Well water was ft. after hours pumping gpm
 Est. Yield gpm: Well water was ft. after hours pumping gpm
 WELL WATER TO BE USED AS: 5 Public water supply 8 Air conditioning 11 Injection well
 1 Domestic 3 Feedlot 6 Oil field water supply 9 Dewatering 12 Other (Specify below)
 2 Irrigation 4 Industrial 7 Domestic (lawn & garden) 10 Monitoring well N-SR
 Was a chemical/bacteriological sample submitted to Department? Yes No ; If yes, mo/day/yr sample was submitted
 Water Well Disinfected? Yes No


5 TYPE OF BLANK CASING USED: 1 Steel 3 RMP (SR) 5 Wrought iron 8 Concrete tile CASING JOINTS: Glued Clamped
2 PVC 4 ABS 6 Asbestos-Cement 9 Other (specify below) Welded
 Blank casing diameter 2 in. to 28 ft., Dia in. to ft., Dia in. to ft.
 Casing height above land surface 24 in., weight lbs./ft. Wall thickness or guage No. SCH/40
 TYPE OF SCREEN OR PERFORATION MATERIAL: 7 PVC 10 Asbestos-Cement
 1 Steel 3 Stainless Steel 5 Fiberglass 8 RMP (SR) 11 Other (Specify)
 2 Brass 4 Galvanized Steel 6 Concrete tile 9 ABS 12 None used (open hole)

SCREEN OR PERFORATION OPENINGS ARE: 1 Continuous slot 3 Mill slot 5 Guazed wrapped 8 Saw cut 11 None (open hole)
 2 Louvered shutter 4 Key punched 6 Wire wrapped 9 Drilled holes
 7 Torch cut 10 Other (specify) ft.
 SCREEN-PERFORATED INTERVALS: From 28 ft. to 38 ft., From ft. to ft.
~~GRAVEL~~ SAND PACK INTERVALS: From 26 ft. to 38 ft., From ft. to ft.
 From ft. to ft., From ft. to ft.

6 GROUT MATERIAL: 1 Neat cement 2 Cement grout 3 Bentonite 4 Other
 Grout Intervals: From 2 ft. to 26 ft., From ft. to ft., From ft. to ft.
 What is the nearest source of possible contamination:
 1 Septic tank 4 Lateral lines 7 Pit privy 1 Fuel storage 10 Livestock pens 14 Abandoned water well
 2 Sewer lines 5 Cess pool 8 Sewage lagoon 12 Fertilizer storage 15 Oil well/Gas well
 3 Watertight sewer lines 6 Seepage pit 9 Feedyard 13 Insecticide storage 16 Other (specify below)
FORMER PIPELINE RELEASE
 Direction from well? WEST How many feet? ~560'

FROM	TO	LITHOLOGIC LOG	FROM	TO	PLUGGING INTERVALS
0	38'	SECTY CLAY, WITH SAND	±3'	2' BGS	5' x 4" x 4" ABOVE GROUND LOCKING WELL PROTECTOR

7 CONTRACTOR'S OR LANDOWNER'S CERTIFICATION: This water well was (1) constructed, (2) reconstructed, or (3) plugged under my jurisdiction and was completed on (mo/day/year) 4/21/09 and this record is true to the best of my knowledge and belief. Kansas Water Well Contractor's Licence No 788 This Water Well Record was completed on (mo/day/yr) 5/19/09 under the business name of ROBERTS ENV. DRILLING, INC. by (signature) Charley W. Roberts

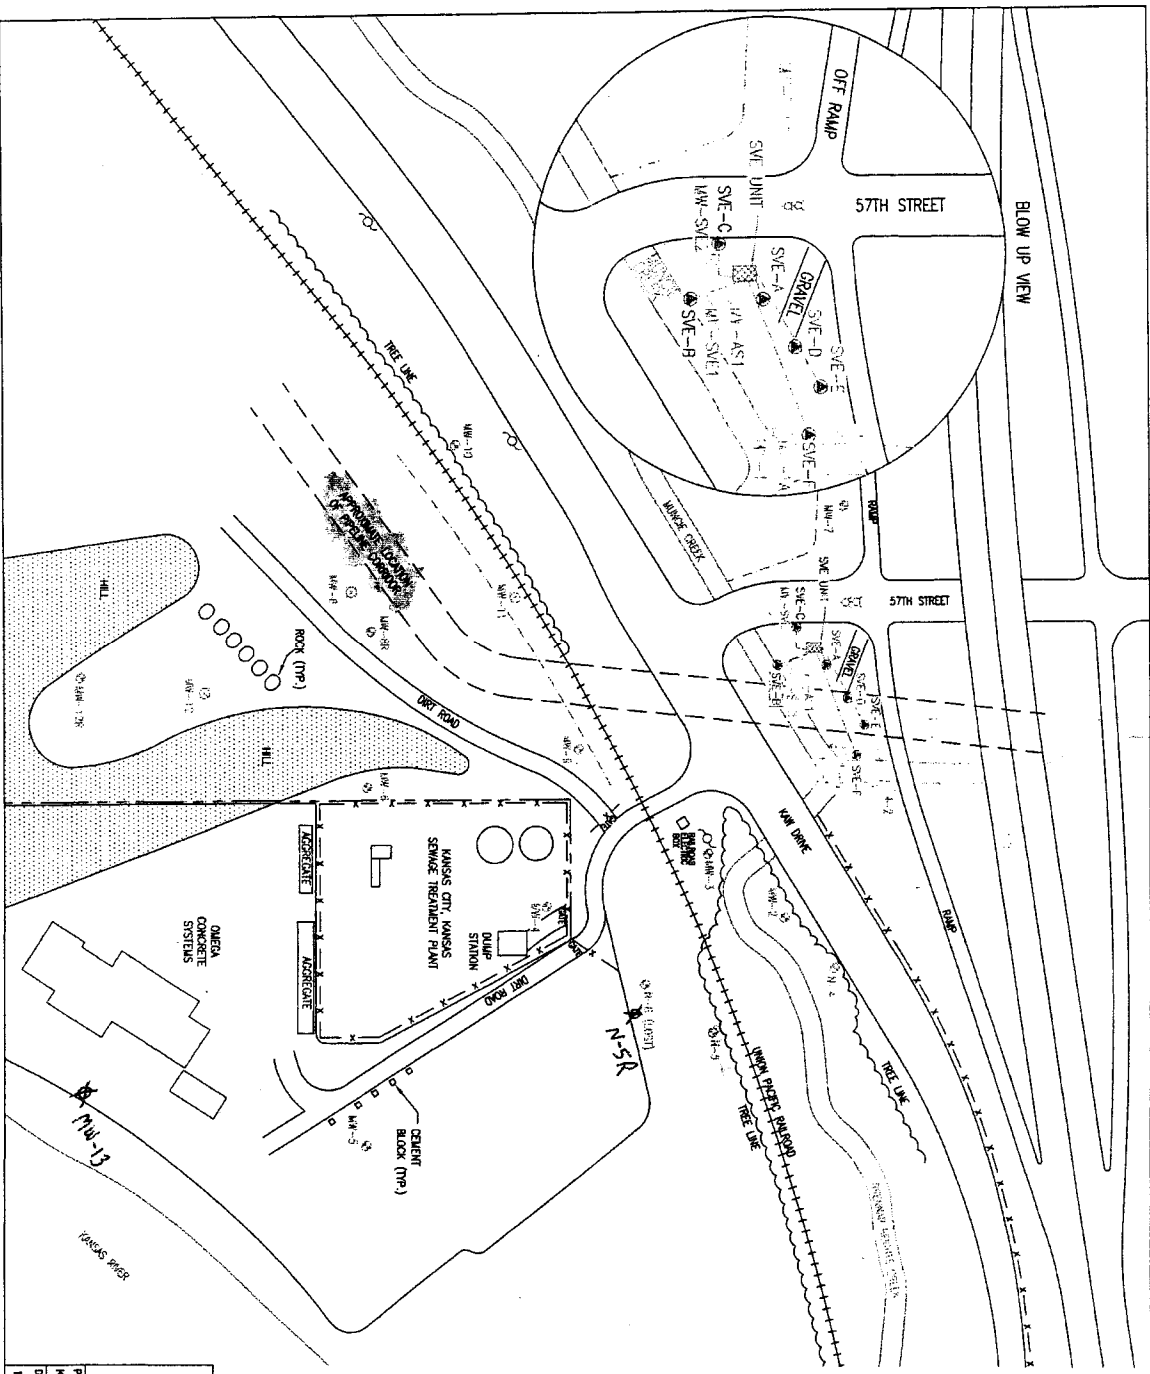


BLOW UP VIEW

LEGEND

- APPROXIMATE PIPELINE LOCATION
- UNAPPROVED, ABANDONED
- APPROVED, OPERATIONAL
- 4 FT. WIRE EDGE
- POINT MARK
- LOW POINT

ABANDONED WELL
MONITORING WELLS

MW-14

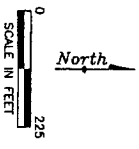

PROJECT NO. K2323-5812-0		PREPARED BY DR/JM		PHILLIPS PIPELINE 1-70 AND 57TH STREET KANSAS CITY, KANSAS
DATE 1/7/79	REVIEWED BY K23235805sm	FILE NAME	DR/JM	
FIGURE 1 SITE MAP				
DELTA				