

# WATER WELL PLUGGING RECORD Form WWC-5P

KSA 82a-1212

ID NO.

MW-10

<b>1 LOCATION OF WATER WELL:</b> County: Johnson	Fraction <u>NE 1/4 SE 1/4 SE 1/4 NE 1/4</u>	Section Number <u>14</u>	Township Number <u>T 11 S</u>	Range Number <u>24</u> <input checked="" type="checkbox"/> E <input type="checkbox"/> W
---	--	-----------------------------	----------------------------------	--

Street/Rural Address of Well Location; if unknown, distance & direction from nearest town or intersection: If at owner's address, check here ☐

## Global Positioning Systems (GPS) information:

Latitude: 39.096371 (in decimal degrees)

Longitude: -94.705630 (in decimal degrees)

Elevation: 754.9

Datum: ☒ WGS84, ☐ NAD83, ☐ NAD27

## Collection Method:


☐ GPS unit (Make/Model: \_\_\_\_\_)

☒ Digital Map/Photo, ☐ Topographic Map, ☐ Land Survey

Est. Accuracy: ☐ < 3 m, ☐ 3-5 m, ☒ 5-15 m, ☐ > 15 m

**2 WATER WELL OWNER:** Ashland Chemical Co.  
RR#, St. Address, Box #: 5420 Speaker Road  
City, State ZIP Code: Kansas City, KS 66106

## 3 MARK WELL'S LOCATION WITH AN "X" IN SECTION BOX:

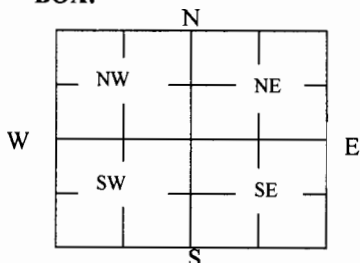

## 4 DEPTH OF WELL 41 ft.

WELL'S STATIC WATER LEVE 29.5 ft

## WELL WAS USED AS:

☐ Domestic  
☐ Irrigation  
☐ Feedlot  
☐ Industrial

☐ Public Water Supply  
☐ Oil Field Water Supply  
☐ Domestic (Lawn & Garden)  
☐ Air Conditioning

☐ Dewatering  
☒ Monitoring  
☐ Injection Well  
☐ Other \_\_\_\_\_

Was a chemical/bacteriological sample submitted to Department? Yes ☒ No ☐

## 5 TYPE OF BLANK CASING USED:

☐ Steel  
☒ PVC

☐ RMP (SR)  
☐ ABS

☐ Wrought  
☐ Asbestos-Cement

☐ Fiberglass  
☐ Concrete Tile

☐ Other (Specify below) \_\_\_\_\_

Blank casing diameter 2 in. Was casing pulled? Yes ☒ No ☐ If yes, how much 3'

Casing height above or below and surface 36 in.

## 6 GROUT PLUG MATERIAL:

☐ Neat cement

☐ Cement grout

☒ Bentonite

☐ Other \_\_\_\_\_

Grout Plug Intervals: From 3 ft. to 41 ft., From \_\_\_\_\_ ft. to \_\_\_\_\_ ft., From \_\_\_\_\_ to \_\_\_\_\_ ft.

What is the nearest source of possible contamination:

☐ Septic tank  
☐ Sewer lines  
☐ Watertight sewer lines  
☐ Lateral lines  
☐ Cess pool

☐ Seepage pit  
☐ Pit privy  
☐ Sewage lagoon  
☐ Feedyard  
☐ Livestock pens

☐ Fuel Storage  
☐ Fertilizer storage  
☐ Insecticide storage  
☐ Abandoned water well  
☐ Oil well/Gas well

☐ Other (specify below) \_\_\_\_\_

Direction from well? \_\_\_\_\_

How many feet? \_\_\_\_\_

FROM	TO	PLUGGING MATERIALS	FROM	TO	PLUGGING MATERIALS
0	3'	Soil, compacted			
3'	41'	Bentonite chips			

**7 CONTRACTOR'S OR LANDOWNER'S CERTIFICATION:** This water well was plugged under my jurisdiction and was completed on (mo/day/year) 5-5-2009 and this record is true to the best of my knowledge and belief. Kansas Water Well Contractor's License No. 655. This Water Well Record was completed on (mo/day/year) 6/1/2009 under the business name of PSC Industrial Outsourcing, LP formerly Philip Environmental by (signature) John Bigsbee

**INSTRUCTIONS:** Use typewriter or ballpoint pen. Please press firmly and print clearly. Please fill in blanks, underline or circle the correct answers. Send top three copies to Kansas Department of Health and Environment, Bureau of Water, Geology Section, 1000 SW Jackson St., Ste. 420, Topeka, Kansas 66612-1367. Telephone: 785/296-5524. Send one to Water Well Owner and retain one for your records. Visit us at <http://www.kdheks.gov/waterwell/index.html>.




Check one:

☐ White Copy


☐ Blue Copy


☐ Pink Copy

- LEGEND**
- MONITORING WELL
  - ⊙ SOIL BORING
  - ⊗ TEMPORARY WELL
  - ABOVE GROUND STORAGE TANK

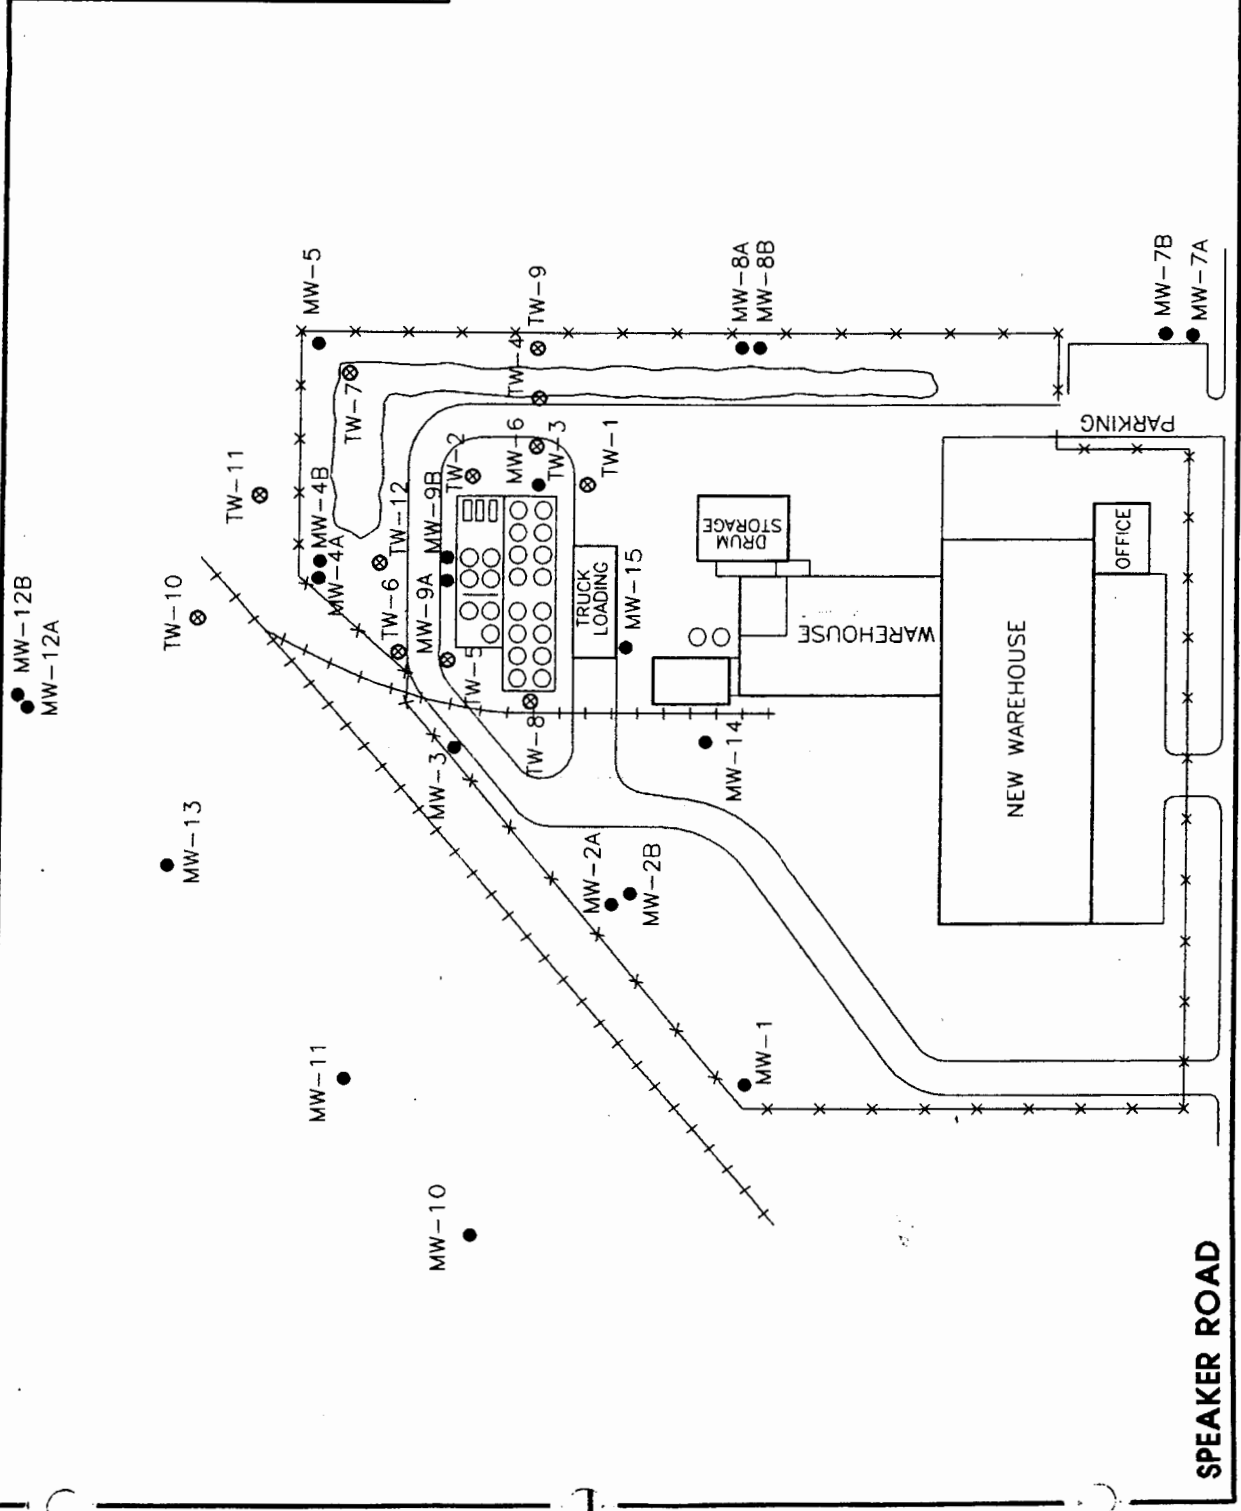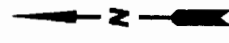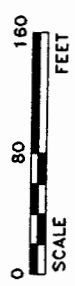

<b>GROUNDWATER TECHNOLOGY</b> 1950 S. FLORENCE WICHITA, KANSAS 67208 (316) 943-3444	
REV. NO.:	DRAWING DATE:
	1/16/96
ACAD FILE: 0488MW	
<b>MONITORING WELL LOCATION MAP</b>	
CLIENT:	ASHLAND I C & S
LOCATION:	KANSAS CITY, KS
DESIGNED:	RHW
PROJECT NO.:	040020488
FIGURE:	5

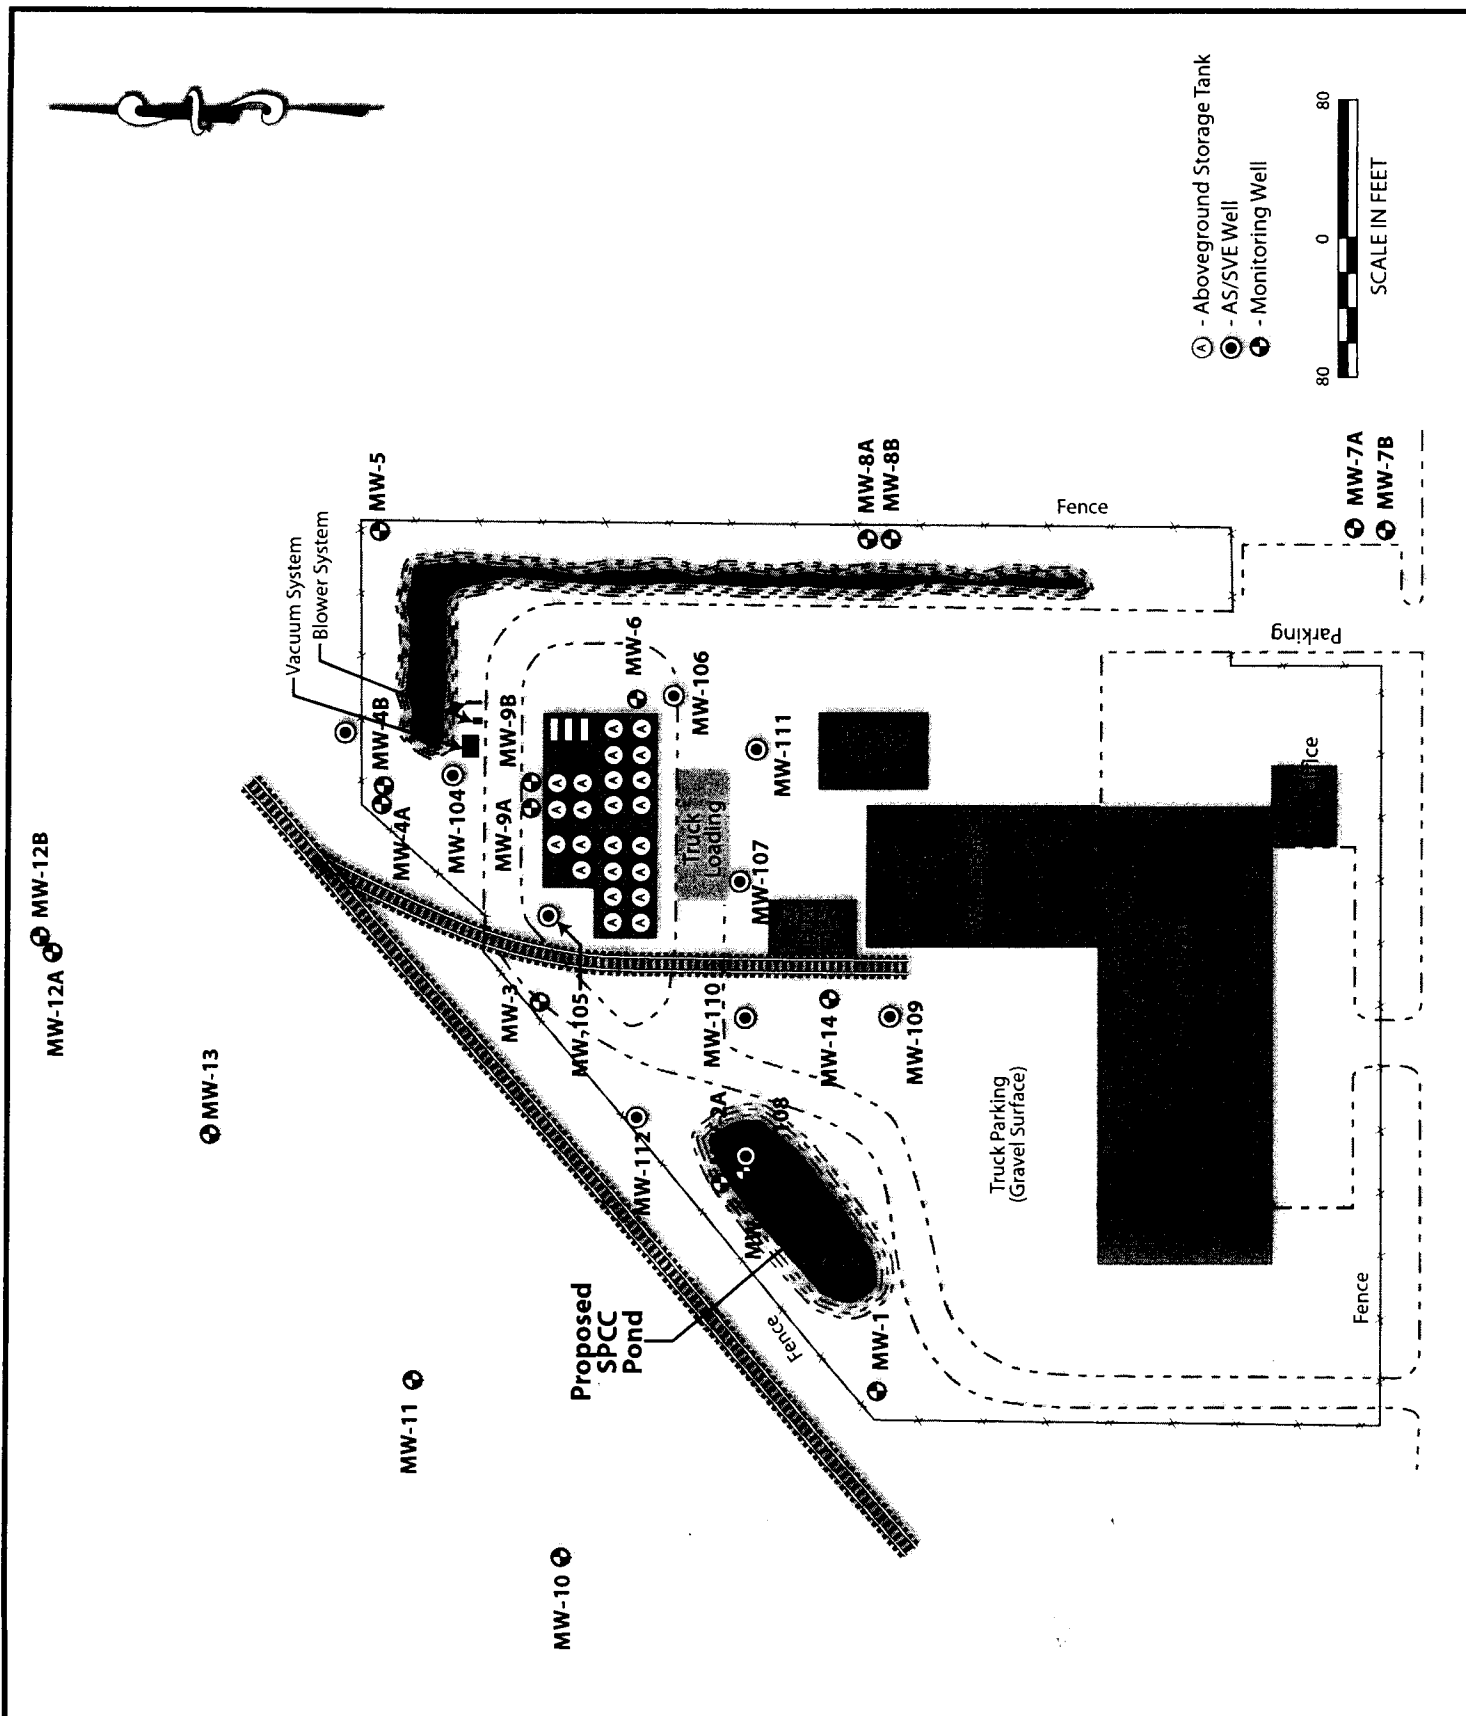

CLIENT: Ashland		TITLE: Proposed SPCC Pond And Existing Monitoring Well Locations	
PROJECT: Kansas City, Kansas			
DATE: August 2006	DESIGNED BY:		PROJ. NO.: 37679572
SCALE: As Shown	DRAWN BY: J. Anderson		TASK: 06800
FILE: H:\proj\Ashland\KansasCityDSO\August 2006\SPCC Pond.ai	CHECKED BY: D. Voykin		FIGURE: 1