


1 LOCATION OF WATER WELL: County: Wyandotte, Fraction: SE 1/4 NW 1/4 SE 1/4, Section Number: 30, Township Number: T 11 S, Range Number: R 24 E/W

Distance and direction from nearest town or city street address of well if located within city? 2140 S. 88th St., Kansas City

2 WATER WELL OWNER: Fuchs Lubricants Company, RR#, St. Address, Box #: 2140 S. 88th Street, City, State, ZIP Code: Kansas City, KS 66111-1756. Board of Agriculture, Division of Water Resources Application Number:

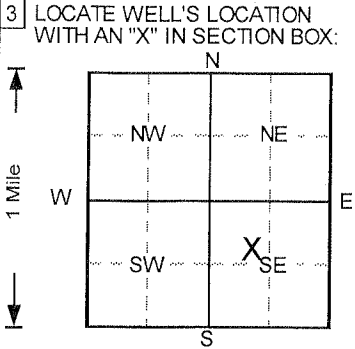

4 DEPTH OF COMPLETED WELL: 20 ft. ELEVATION: ... WELL'S STATIC WATER LEVEL ... Pump test data: Well water was NA ft. after ... hours pumping ... gpm. Bore Hole Diameter: 8 in. to 20 ft. WELL WATER TO BE USED AS: 12 Other (Specify below) Soil vapor extractio... Was a chemical/bacteriological sample submitted? Yes.....No [checked] ... Water Well Disinfected? Yes No [checked]

5 TYPE OF BLANK CASING USED: 1 Steel, 2 PVC, 3 RMP (SR), 4 ABS, 5 Wrought iron, 6 Asbestos-Cement, 7 Fiberglass, 8 Concrete tile, 9 Other (specify below), CASING JOINTS: Glued, Clamped, Welded, Threaded [checked]. Blank casing diameter: 4 in. to 5 ft., Dia. ... Casing height above land surface: 0 in., weight ... lbs./ft. Wall thickness or gauge No. Sch. 40.

TYPE OF SCREEN OR PERFORATION MATERIAL: 1 Steel, 2 Brass, 3 Stainless steel, 4 Galvanized steel, 5 Fiberglass, 6 Concrete tile, 7 PVC [checked], 8 RMP (SR), 10 Asbestos-cement, 11 Other (specify), 12 None used (open hole). SCREEN OR PERFORATION OPENINGS ARE: 1 Continuous slot, 2 Louvered shutter, 3 Mill slot [checked], 4 Key punched, 5 Gauzed wrapped, 6 Wire wrapped, 8 Saw cut, 9 Drilled holes, 11 None (open hole), 10 Other (specify). SCREEN-PERFORATED INTERVALS: From 5 ft. to 20 ft. GRAVEL PACK INTERVALS: From 4 ft. to 20 ft.

6 GROUT MATERIAL: 1 Neat cement, 2 Cement grout, 3 Bentonite [checked], 4 Other. Grout Intervals: From 1 ft. to 4 ft., From ... ft. to ... ft., From ... ft. to ... ft. What is the nearest source of possible contamination: 1 Septic tank, 2 Sewer lines, 3 Watertight sewer lines, 4 Lateral lines, 5 Cess pool, 6 Seepage pit, 7 Pit privy, 8 Sewage lagoon, 9 Feedyard, 10 Livestock pens, 11 Fuel storage, 12 Fertilizer storage, 13 Insecticide storage, 14 Abandoned water well, 15 Oil well/Gas well, 16 Other (specify below). Direction from well? How many feet?

Table with columns: FROM, TO, LITHOLOGIC LOG, FROM, TO, PLUGGING INTERVALS. Data includes: 0 to 0.5 Concrete, 0.5 to 6.5 Silt, some clay, V. Dark Gray, 6.5 to 14 Silt, Gray, 14 to 24 Sand (f), some silt, Dark Gray. Entry: SVE3, Flushmount.

7 CONTRACTOR'S OR LANDOWNER'S CERTIFICATION: This water well was (1) constructed, (2) reconstructed, or (3) plugged under my jurisdiction and was completed on (mo/day/year) 2/10/2009 and this record is true to the best of my knowledge and belief. Kansas Water Well Contractor's License No. 527. This Water Well Record was completed on (mo/day/yr) 3/25/2009 under the business name of GeoCore, Inc. by (signature) DALE ROGL by GeoCore