


1 LOCATION OF WATER WELL: County: **Wyandotte** Fraction **SE 1/4 NW 1/4 SE 1/4** Section Number **30** Township Number **T 11 S** Range Number **R 24** E/W

Distance and direction from nearest town or city street address of well if located within city?
2140 S. 88th St., Kansas City

2 WATER WELL OWNER: **Fuchs Lubricants Company**
 RR#, St. Address, Box # : **2140 S. 88th Street** Board of Agriculture, Division of Water Resources.
 City, State, ZIP Code : **Kansas City, KS 66111-1756** Application Number:

3 LOCATE WELL'S LOCATION WITH AN "X" IN SECTION BOX:

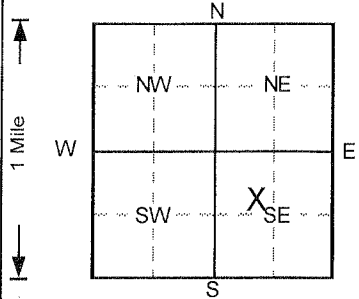

4 DEPTH OF COMPLETED WELL **26** ft. ELEVATION:

Depth(s) Groundwater Encountered 1. ft. 2. ft. 3. ft.
 WELL'S STATIC WATER LEVEL ft. below land surface measured on mo/day/yr
 Pump test data: Well water was **NA** ft. after hours pumping gpm
 Est. Yield . . **NA** . . . gpm: Well water was ft. after hours pumping gpm
 Bore Hole Diameter **8** in. to **26** ft., and in. to ft.
 WELL WATER TO BE USED AS: 5 Public water supply 8 Air conditioning 11 Injection well
 1 Domestic 3 Feedlot 6 Oil field water supply 9 Dewatering **12** Other (Specify below)
 2 Irrigation 4 Industrial 7 Lawn and garden only 10 Monitoring well **Soil vapor extraction**
 Was a chemical/bacteriological sample submitted to Department? Yes.....No ; If yes, mo/day/yr sample was submitted
 Water Well Disinfected? Yes No

5 TYPE OF BLANK CASING USED: 1 Steel 3 RMP (SR) 5 Wrought iron 8 Concrete tile CASING JOINTS: Glued Clamped
 2 PVC 4 ABS 6 Asbestos-Cement 9 Other (specify below) Welded
 7 Fiberglass Threaded.

Blank casing diameter **4** in. to **6** ft., Dia in. to ft., Dia in. to ft.
 Casing height above land surface in., weight lbs./ft. Wall thickness or gauge No. **Sch. 40**

TYPE OF SCREEN OR PERFORATION MATERIAL 7 PVC 10 Asbestos-cement
 1 Steel 3 Stainless steel 5 Fiberglass 8 RMP (SR) 11 Other (specify)
 2 Brass 4 Galvanized steel 6 Concrete tile 9 ABS 12 None used (open hole)

SCREEN OR PERFORATION OPENINGS ARE: 5 Gauzed wrapped 8 Saw cut 11 None (open hole)
 1 Continuous slot 3 Mill slot 6 Wire wrapped 9 Drilled holes
 2 Louvered shutter 4 Key punched 7 Torch cut 10 Other (specify)

SCREEN-PERFORATED INTERVALS: From **6** ft. to **26** ft., From ft. to ft. ft.
 From ft. to ft., From ft. to ft. ft.

GRAVEL PACK INTERVALS: From **4.5** ft. to **26** ft., From ft. to ft. ft.
 From ft. to ft., From ft. to ft. ft.

6 GROUT MATERIAL: 1 Neat cement 2 Cement grout 3 Bentonite 4 Other
 Grout Intervals: From **2** ft. to **4.5** ft., From ft. to ft., From ft. to ft.

What is the nearest source of possible contamination:

- 1 Septic tank 4 Lateral lines 7 Pit privy 10 Livestock pens 14 Abandoned water well
 2 Sewer lines 5 Cess pool 8 Sewage lagoon 11 Fuel storage 15 Oil well/Gas well
 3 Watertight sewer lines 6 Seepage pit 9 Feedyard 12 Fertilizer storage 16 Other (specify below)
 13 Insecticide storage
 Direction from well? How many feet?

FROM	TO	LITHOLOGIC LOG	FROM	TO	PLUGGING INTERVALS
0	0.25	Grass,			
0.25	8	Silt, Grayish Brown			
8	26	Silt, Gray			
					SVE8, Flushmount

7 CONTRACTOR'S OR LANDOWNER'S CERTIFICATION: This water well was **1** constructed, (2) reconstructed, or (3) plugged under my jurisdiction and was completed on (mo/day/year) **3/4/2009** and this record is true to the best of my knowledge and belief. Kansas Water Well Contractor's License No. **527** This Water Well Record was completed on (mo/day/yr) **3/25/2009** under the business name of **GeoCore, Inc.** by (signature) DALE ROSE by JSM