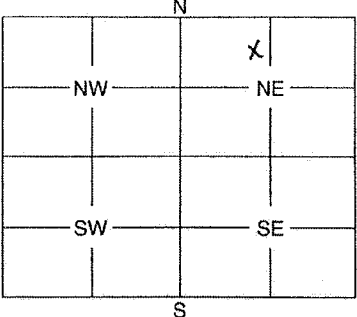


| | | | | | |
|---|--|--|---------------------|------------------------|-------------------------|
| 1 | LOCATION OF WATER WELL: 8037 Parallel Pkwy County: Wyandotte | Fraction E/2 - NW - NE 1/4 1/4 1/4 | Section Number 5 | Township Number 11S | Range Number 24 (EW) |
|---|--|--|---------------------|------------------------|-------------------------|

Distance and direction from nearest town or city street address of well if located within city?

| | | |
|---|--|--|
| 2 | WATER WELL OWNER: ATOT RR #, St. Address, Box #: 8037 Parallel Parkway City, State, ZIP Code: Kan. City Kan. 66101 | Board of Agriculture, Division of Water Resources Application Number: |
|---|--|--|

| | | | |
|---|---|---|--|
| 3 | MARK WELL'S LOCATION WITH AN "X" IN SECTION BOX:  | 4 | DEPTH OF WELL 11.0 ft. WELL'S STATIC WATER LEVEL 3.0 ft. WELL WAS USED AS: 1 Domestic 2 Irrigation 3 Feedlot 4 Industrial 5 Public Water Supply 6 Oil Field Water Supply 7 Domestic (Lawn & Garden) 8 Air Conditioning 9 Dewatering 10 Monitoring Well 11 Injection Well 12 Other Was a chemical / bacteriological sample submitted to Department? Yes No <u>X</u> If yes, mo/day/yr sample was submitted Water Well Disinfected: Yes No <u>X</u> |
|---|---|---|--|

| | |
|---|--|
| 5 | TYPE OF BLANK CASING USED: 1 Steel 2 PVC 3 RMP (SR) 4 ABS 5 Wrought 6 Asbestos-Cement 7 Fiberglass 8 Concrete Tile 9 Other (Specify below) Blank casing diameter 2 in. Was casing pulled? Yes No <u>X</u> If yes, how much Casing height above or below land surface 36 in. |
|---|--|

| | |
|---|---|
| 6 | GROUT PLUG MATERIAL: 1 Neat cement 2 Cement grout 3 Bentonite 4 Other Grout Plug Intervals: From 11.0 ft. to 3.0 ft., From ft. to ft., From to ft. What is the nearest source of possible contamination: 1 Septic tank 6 Seepage pit 11 Fuel storage 16 Other (specify below) 2 Sewer lines 7 Pit privy 12 Fertilizer storage 3 Watertight sewer lines 8 Sewage lagoon 13 Insecticide storage 4 Lateral lines 9 Feedyard 14 Abandoned water well 5 Cess pool 10 Livestock pens 15 Oil well/Gas well Direction from well? How many feet? |
|---|---|

| FROM | TO | PLUGGING MATERIALS |
|-------|---------|--------------------|
| 11.0' | 3.0' | Bentonite |
| 3.0' | .5' | clay |
| .5' | surface | cement |
| | | |
| | | |
| | | |
| | | |

| | |
|---|---|
| 7 | CONTRACTOR'S OF LANDOWNER'S CERTIFICATION: This water well was plugged under my jurisdiction and was completed on (mo/day/year) 8/18/2011 and this record is true to the best of my knowledge and belief. Kansas Water Well Contractor's License No. 527 This Water Well Record was completed on (mo/day/year) 8/26/11 under the business name of GEOTECHNOLOGY, LLC by (signature) [Signature] |
|---|---|

INSTRUCTIONS: Use typewriter or ball point pen. Please press firmly and print clearly. Please fill in blanks, underline or circle the correct answers. Send top three copies to Kansas Department of Health and Environment, Bureau of Water, Geology Section, 1000 SW Jackson St., Ste. 420, Topeka, Kansas 66612-1367. Telephone: 785/296-5522. Send one to Water Well Owner and retain one for your records.