


1	LOCATION OF WATER WELL: <u>8037 Parallel Pkwy</u>	Fraction <u>E/2 - NW - NE</u> 1/4 1/4 1/4	Section <u>5</u>	Number	Township <u>11S</u>	Number	Range <u>24</u>	Number <u>E/W</u>
County: <u>Wyandotte</u>								

Distance and direction from nearest town or city street address of well if located within city?

2 WATER WELL OWNER: AT&T
 RR #, St. Address, Box #: 8037 Parallel Parkway
 City, State, ZIP Code: Kan. City Kan.

Board of Agriculture, Division of Water Resources
Application Number:

3 MARK WELL'S LOCATION WITH AN "X" IN SECTION BOX:

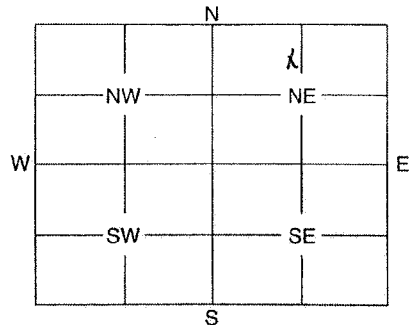

4 DEPTH OF WELL 12.0 ft.

WELL'S STATIC WATER LEVEL 2.0 ft.

WELL WAS USED AS:

- 1 Domestic
- 2 Irrigation
- 3 Feedlot
- 4 Industrial

- 5 Public Water Supply
- 6 Oil Field Water Supply
- 7 Domestic (Lawn & Garden)
- 8 Air Conditioning

- 9 Dewatering
- 10 Monitoring Well
- 11 Injection Well
- 12 Other

Was a chemical / bacteriological sample submitted to Department? Yes No X

If yes, mo/day/yr sample was submitted

Water Well Disinfected: Yes No X

5 TYPE OF BLANK CASING USED:

- 1 Steel
- 2 PVC
- 3 RMP (SR)
- 4 ABS
- 5 Wrought
- 6 Asbestos-Cement
- 7 Fiberglass
- 8 Concrete Tile
- 9 Other (Specify below)

Blank casing diameter 2 in. Was casing pulled? Yes No X If yes, how much
 Casing height above or below land surface 36 in.

6 GROUT PLUG MATERIAL: 1 Neat cement 2 Cement grout 3 Bentonite 4 Other
 Grout Plug Intervals: From 12.0 ft. to 3.0 ft., From 3.0 ft. to 0.5 ft., From 0.5 ft. to surface

What is the nearest source of possible contamination:

- 1 Septic tank
- 2 Sewer lines
- 3 Watertight sewer lines
- 4 Lateral lines
- 5 Cess pool
- 6 Seepage pit
- 7 Pit privy
- 8 Sewage lagoon
- 9 Feedyard
- 10 Livestock pens
- 11 Fuel storage
- 12 Fertilizer storage
- 13 Insecticide storage
- 14 Abandoned water well
- 15 Oil well/Gas well
- 16 Other (specify below)

Direction from well? How many feet?

FROM	TO	PLUGGING MATERIALS
12.0'	3.0'	Bentonite
3.0	.5'	clay
.5'	surface	cement

7 CONTRACTOR'S OF LANDOWNER'S CERTIFICATION: This water well was plugged under my jurisdiction and was completed on (mo/day/year) 8/18/2011 and this record is true to the best of my knowledge and belief. Kansas Water Well Contractor's License No. 529 This Water Well Record was completed on (mo/day/year) 8/20/11 under the business name of GEOTECHNOLOGY, INC.
 by (signature) [Signature]

INSTRUCTIONS: Use typewriter or ball point pen. Please press firmly and print clearly. Please fill in blanks, underline or circle the correct answers. Send top three copies to Kansas Department of Health and Environment, Bureau of Water, Geology Section, 1000 SW Jackson St., Ste. 420, Topeka, Kansas 66612-1367. Telephone: 785/296-5522. Send one to Water Well Owner and retain one for your records.

Check one: ☒ White Copy ☐ Blue Copy ☐ Pink Copy