


1 LOCATION OF WATER WELL: County: Wyandotte Fraction NW 1/4 SE 1/4 SE 1/4 Section Number 11 Township Number T 11 S Range Number R 24 EW

Distance and direction from nearest town or city street address of well if located within city? 57th Street and I-70, Kansas City

2 WATER WELL OWNER: Conoco Phillips 1354 Phillips Building RR#, St. Address, Box # 420 South Keeler Ave. City, State, ZIP Code Bartlesville, OK 74004 Board of Agriculture, Division of Water Resources Application Number:

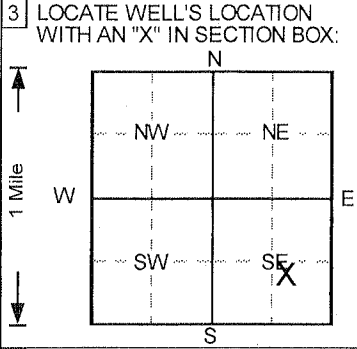

3 LOCATE WELL'S LOCATION WITH AN 'X' IN SECTION BOX: 4 DEPTH OF COMPLETED WELL 25 ft. ELEVATION: ... Depth(s) Groundwater Encountered: 1. ... ft. 2. ... ft. 3. ... ft. WELL'S STATIC WATER LEVEL ... ft. below land surface measured on mo/day/yr ... Pump test data: Well water was NA ft. after ... hours pumping ... gpm Est. Yield NA gpm: Well water was ... ft. after ... hours pumping ... gpm Bore Hole Diameter 11 in. to 25 ft., and ... in. to ... ft. WELL WATER TO BE USED AS: 5 Public water supply 8 Air conditioning 11 Injection well 1 Domestic 3 Feedlot 6 Oil field water supply 9 Dewatering 12 Other (Specify below) Soil vapor extractio. 2 Irrigation 4 Industrial 7 Lawn and garden only 10 Monitoring well Was a chemical/bacteriological sample submitted to Department? Yes No [checked] If yes, mo/day/yr sample was submitted Water Well Disinfected? Yes No [checked]

5 TYPE OF BLANK CASING USED: 1 Steel 3 RMP (SR) 5 Wrought iron 8 Concrete tile CASING JOINTS: Glued Clamped Welded Threaded [checked] 2 PVC 4 ABS 7 Fiberglass Blank casing diameter 4 in. to 15 ft., Dia in. to ... ft., Dia in. to ... ft. Casing height above land surface ... in., weight ... lbs./ft. Wall thickness or gauge No. Sch. 40 TYPE OF SCREEN OR PERFORATION MATERIAL: 1 Steel 3 Stainless steel 5 Fiberglass 7 PVC 10 Asbestos-cement 2 Brass 4 Galvanized steel 6 Concrete tile 8 RMP (SR) 11 Other (specify) 12 None used (open hole) SCREEN OR PERFORATION OPENINGS ARE: 1 Continuous slot 3 Mill slot 5 Gauzed wrapped 8 Saw cut 11 None (open hole) 2 Louvered shutter 4 Key punched 6 Wire wrapped 9 Drilled holes 10 Other (specify) SCREEN-PERFORATED INTERVALS: From 15 ft. to 25 ft., From ... ft. to ... ft. GRAVEL PACK INTERVALS: From 13 ft. to 25 ft., From ... ft. to ... ft.

6 GROUT MATERIAL: 1 Neat cement 2 Cement grout 3 Bentonite 4 Other Concrete Grout Intervals: From 0 ft. to 1 ft., From 1 ft. to 15 ft., From ... ft. to ... ft. What is the nearest source of possible contamination: 1 Septic tank 4 Lateral lines 7 Pit privy 10 Livestock pens 14 Abandoned water well 2 Sewer lines 5 Cess pool 8 Sewage lagoon 11 Fuel storage 15 Oil well/Gas well 3 Watertight sewer lines 6 Seepage pit 9 Feedyard 12 Fertilizer storage 16 Other (specify below) 13 Insecticide storage Direction from well? How many feet?

FROM	TO	LITHOLOGIC LOG	FROM	TO	PLUGGING INTERVALS
0	0.5	Topsoil w/rootlets,			
0.5	4	Clay, v. silty, Med. Brown			
4	10.5	Silt, sl. clay, Lt. Yellow Brown			
10.5	11.5	Silt, sandy, Lt. Yellow Brown			
11.5	14	Silt, Lt. Yellow Brown			
14	21	Sand, vf-m,			
21	25	Sand, vf-c, Lt. Yellow Brown			
					SVE3, Abovegrade

7 CONTRACTOR'S OR LANDOWNER'S CERTIFICATION: This water well was (1) constructed, (2) reconstructed, or (3) plugged under my jurisdiction and was completed on (mo/day/year) 11/30/2011 and this record is true to the best of my knowledge and belief. Kansas Water Well Contractor's License No. 527. This Water Well Record was completed on (mo/day/yr) 12/29/11 under the business name of GeoCore, Inc. by (signature) Dale [signature]