

County: Wichita Fraction SE-NW-NE Sec. 32 T 11 S R 24 (E)W

CORRECTION(S) TO WATER WELL COMPLETION RECORD (WWC-5)

(to rectify lacking or incorrect information)

Owner: BNSF Railroad Company

Location was listed as:

Section-Township-Range: 32 - 11 S - 24 E

Fraction (1/4 1/4 1/4): None

Location changed to:

32 - 11 S - 24 E

SE - NW - NE

Other changes: Initial statements: Latitude = 38.05633

Changed to: 39.05633

Comments: _____

Verification method: Found other BNSF sites at PLSS location, Added One Deg to latitude and Lat/Long placed within section.

initials: DF date: 4/15/14

Submitted by: Kansas Geological Survey, Data Resources Library, 1930 Constant Ave., Lawrence, KS 66047-3726

to: Kansas Dept of Health & Environment, Bureau of Water, 1000 SW Jackson, Suite 420, Topeka, KS 66612-1367.

17

WATER WELL RECORD


Form WWC-5

Division of Water Resources App. No.

1 LOCATION OF WATER WELL: County: Wyandotte, Fraction 1/4 1/4 1/4 1/4, Section Number 32, Township No. T 11 S, Range Number R 24 [X]E []W

Street/Rural Address of Well Location; if unknown, distance & direction from nearest town or intersection: If at owner's address, check here []. 78th & Holiday Drive; Kansas City, KS. Global Positioning System (GPS) information: Latitude: .38.05633, Longitude: 94.76691, Elevation: , Datum: [X] WGS 84, [] NAD 83, [] NAD 27, Collection Method: [X] GPS unit (Make/Model: Garmin etrex 10), [] Digital Map/Photo, [] Topographic Map, [] Land Survey, Est. Accuracy: [] <3 m, [X] 3-5 m, [] 5-15 m, [] >15 m

2 WATER WELL OWNER: BNSF Railway Company, RR#, Street Address, Box #: 4515 Kansas Ave., City, State, ZIP Code : Kansas City, KS 66106

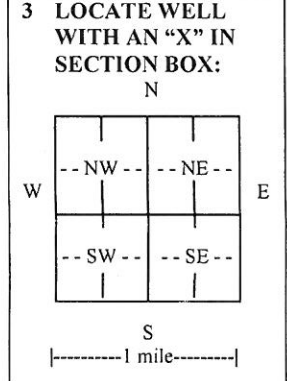

3 LOCATE WELL WITH AN "X" IN SECTION BOX: N, E, S, W. 4 DEPTH OF COMPLETED WELL 70 ft. Depth(s) Groundwater Encountered (1).55 ft. (2). ft. (3). ft. WELL'S STATIC WATER LEVEL . ft. below land surface measured on mo/day/yr . Pump test data: Well water was . ft. after . hours pumping . gpm EST. YIELD . gpm. Well water was . ft. after . hours pumping . gpm Bore Hole Diameter 8 in. to .70 ft., and . in. to . ft. WELL WATER TO BE USED AS: [] Domestic [] Feedlot [] Oil field water supply [] Geothermal [] Injection well [] Irrigation [] Industrial [] Domestic-lawn & garden [X] Monitoring well [] Other (Specify below) Was a chemical/bacteriological sample submitted to Department? [] Yes [X] No If yes, mo/day/yr sample was submitted. Water well disinfected? [] Yes [X] No

5 TYPE OF CASING USED: [] Steel [X] PVC [] Other CASING JOINTS: [] Glued [] Clamped [] Welded [X] Threaded Casing diameter 2 in. to .55 ft., Diameter . in. to . ft., Diameter . in. to . ft. Casing height above land surface .30 in., Weight . lbs./ft., Wall thickness or gauge No. Sch. 40 TYPE OF SCREEN OR PERFORATION MATERIAL: [] Steel [] Stainless Steel [X] PVC [] Other (Specify) [] Brass [] Galvanized Steel [] None used (open hole) SCREEN OR PERFORATION OPENINGS ARE: [] Continuous slot [X] Mill slot [] Gauze wrapped [] Torch cut [] Drilled holes [] None (open hole) [] Louvered shutter [] Key punched [] Wire wrapped [] Saw cut [] Other (specify) SCREEN-PERFORATED INTERVALS: From .70 ft. to .55 ft., From . ft. to . ft., From . ft. to . ft. GRAVEL PACK INTERVALS: From .70 ft. to .53 ft., From . ft. to . ft., From . ft. to . ft.

6 GROUT MATERIAL: [] Neat cement [] Cement grout [X] Bentonite [] Other Grout Intervals: From .53 ft. to .2 ft., From . ft. to . ft., From . ft. to . ft. What is the nearest source of possible contamination: [] Septic tank [] Lateral lines [] Pit privy [] Livestock pens [] Insecticide storage [] Other (specify below) [] Sewer lines [] Cesspool [] Sewage lagoon [X] Fuel storage [] Abandoned water well [] Watertight sewer lines [] Seepage pit [] Feedyard [] Fertilizer storage [] Oil well/gas well Direction from well . Distance from well .

Table with columns: FROM, TO, LITHOLOGIC LOG, FROM, TO, LITHO. LOG (cont.) or PLUGGING INTERVALS. Rows: 0-5 Dark Brown Clay, 5-7 Brown Sity Clay, 7-69 Fine to Very Fine Sand, 69-70 Weathered Shale.

7 CONTRACTOR'S OR LANDOWNER'S CERTIFICATION: This water well was [X] constructed, [] reconstructed, or [] plugged under my jurisdiction and was completed on (mo/day/year) .1/29/2014. and this record is true to the best of my knowledge and belief. Kansas Water Well Contractor's License No. .710. This Water Well Record was completed on (mo/day/year) 2/24/2013 under the business name of .Below Ground Surface, Inc. by (signature) .

INSTRUCTIONS: Use typewriter or ball point pen. PLEASE PRESS FIRMLY and PRINT clearly. Please fill in blanks and check the correct answers. Send three copies (white, blue, pink) to Kansas Department of Health and Environment, Bureau of Water, Geology Section, 1000 SW Jackson St., Suite 420, Topeka, Kansas 66612-1367. Telephone 785-296-5524. Send one copy to WATER WELL OWNER and retain one for your records. I include fee of \$5.00 for each constructed well. Visit us at http://www.kdheks.gov/waterwell/index.html.