

mw-13

WATER WELL RECORD

Form WWC-5


Division of Water Resources App. No.

1 LOCATION OF WATER WELL: County: Wyandotte, Fraction: 1/4 NW 1/4 SE 1/4 SE 1/4, Section Number: 11, Township No. T 11 S, Range Number R 24 E W

Street/Rural Address of Well Location; if unknown, distance & direction from nearest town or intersection: If at owner's address, check here [] east of 57th street between Kaw Drive and I-70 ramp

2 WATER WELL OWNER: Phillips 66 Company, RR#, Street Address, Box #: 420 South Keller, City, State, ZIP Code: Bartlesville, OK 74004

Global Positioning System (GPS) information: Latitude: 39.06.15.39, Longitude: 94.42.33.60, Elevation: ... Datum: [] WGS 84, [] NAD 83, [] NAD 27

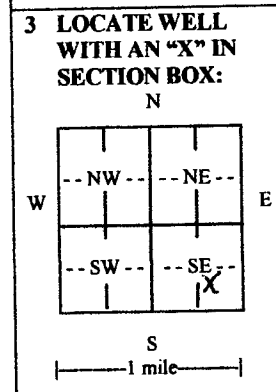

3 LOCATE WELL WITH AN 'X' IN SECTION BOX: ... 4 DEPTH OF COMPLETED WELL 44.89 ft. Depth(s) Groundwater Encountered (1) 33.81 ft. (2) ... ft. (3) ... ft. WELL'S STATIC WATER LEVEL ... ft. below land surface measured on mo/day/yr ...

5 TYPE OF CASING USED: [] Steel [x] PVC [] Other ... CASING JOINTS: [] Glued [] Clamped [] Welded [x] Threaded ... TYPE OF SCREEN OR PERFORATION MATERIAL: [] Steel [] Stainless Steel [x] PVC [] Other (Specify) ...

6 GROUT MATERIAL: [] Neat cement [] Cement grout [x] Bentonite [] Other ... Grout Intervals: From 0 ft. to 40.89 ft. ... What is the nearest source of possible contamination: [] Septic tank [] Lateral lines [] Pit privy [] Livestock pens [] Insecticide storage [] Other (specify below)

Table with 4 columns: FROM, TO, LITHOLOGIC LOG, LITHO. LOG (cont.) or PLUGGING INTERVALS. Row 1: FROM, TO, NA, LITHO. LOG (cont.) or PLUGGING INTERVALS

7 CONTRACTOR'S OR LANDOWNER'S CERTIFICATION: This water well was [x] constructed, [] reconstructed, or [] plugged under my jurisdiction and was completed on (mo/day/year) 4/9/2014 ... and this record is true to the best of my knowledge and belief.

INSTRUCTIONS: Use typewriter or ball point pen. PLEASE PRESS FIRMLY and PRINT clearly. Please fill in blanks and check the correct answers. Send one copy to Kansas Department of Health and Environment, Bureau of Water, Geology Section, 1000 SW Jackson St., Suite 420, Topeka, Kansas 66612-1367.