

MW-16

WATER WELL RECORD


Form WWC-5

Division of Water Resources App. No.

1 LOCATION OF WATER WELL: County: Wyandotte Fraction 1/4 NW 1/4 SE 1/4 SE 1/4 Section Number 11 Township No. T 11 S Range Number R 24 NE W

Street/Rural Address of Well Location; if unknown, distance & direction from nearest town or intersection: If at owner's address, check here [] east of 57th street between Kaw Drive and I-70 ramp Global Positioning System (GPS) information: Latitude: 39.06.15.85 Longitude: 94.42.33.33

2 WATER WELL OWNER: Phillips 66 Company RR#, Street Address, Box #: 420 South Keller City, State, ZIP Code : Bartlesville, OK 74004 Collection Method: [] GPS unit [] Digital Map/Photo [] Topographic Map [] Land Survey Est. Accuracy: [] <3 m [] 3-5 m [] 5-15 m [] >15 m

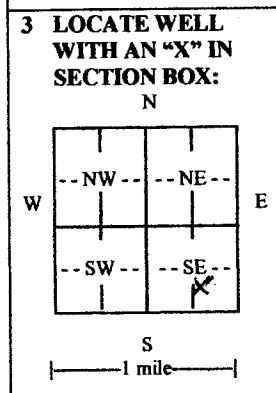

3 LOCATE WELL WITH AN 'X' IN SECTION BOX: 4 DEPTH OF COMPLETED WELL 45.01 ft. Depth(s) Groundwater Encountered (1) 35.45 ft. (2) ft. (3) ft. WELL'S STATIC WATER LEVEL ft. below land surface measured on mo/day/yr. Pump test data: Well water was ft. after hours pumping gpm EST. YIELD gpm Well water was ft. after hours pumping gpm Bore Hole Diameter 3.25 in. to ft. and in. to ft. WELL WATER TO BE USED AS: [] Public water supply [] Geothermal [X] Injection well [] Domestic [] Feedlot [] Oil field water supply [] Dewatering [] Other (Specify below) [] Irrigation [] Industrial [] Domestic-lawn & garden [X] Monitoring well Was a chemical/bacteriological sample submitted to Department? [] Yes [X] No If yes, mo/day/yr sample was submitted Water well disinfected? [] Yes [X] No

5 TYPE OF CASING USED: [] Steel [X] PVC [] Other CASING JOINTS: [] Glued [] Clamped [] Welded [X] Threaded Casing diameter 1 in. to 43.01 ft. Diameter in. to ft. Diameter in. to ft. Casing height above land surface 36 in. Weight lbs./ft. Wall thickness or gauge No. sch 40 TYPE OF SCREEN OR PERFORATION MATERIAL: [] Steel [] Stainless Steel [X] PVC [] Other (Specify) [] Brass [] Galvanized Steel [] None used (open hole) SCREEN OR PERFORATION OPENINGS ARE: [] Continuous slot [X] Mill slot [] Gauze wrapped [] Torch cut [] Drilled holes [] None (open hole) [] Louvered shutter [] Key punched [] Wire wrapped [] Saw cut [X] Other (specify) SCREEN-PERFORATED INTERVALS: From 43.01 ft. to 45.01 ft. GRAVEL PACK INTERVALS: From 41.01 ft. to 45.01 ft.

6 GROUT MATERIAL: [] Neat cement [] Cement grout [X] Bentonite [] Other Grout Intervals: From 0 ft. to 41.01 ft. What is the nearest source of possible contamination: [] Septic tank [] Lateral lines [] Pit privy [] Livestock pens [] Insecticide storage [] Other (specify below) [] Sewer lines [] Cesspool [] Sewage lagoon [] Fuel storage [] Abandoned water well [] Watertight sewer lines [] Seepage pit [] Feedyard [] Fertilizer storage [] Oil well/gas well Direction from well Distance from well

Table with columns: FROM, TO, LITHOLOGIC LOG, FROM, TO, LITHO. LOG (cont.) or PLUGGING INTERVALS. Row 1: FROM, TO, NA, FROM, TO, LITHO. LOG (cont.) or PLUGGING INTERVALS

7 CONTRACTOR'S OR LANDOWNER'S CERTIFICATION: This water well was [X] constructed, [] reconstructed, or [] plugged under my jurisdiction and was completed on (mo/day/year) 4/9/2014 and this record is true to the best of my knowledge and belief. Kansas Water Well Contractor's License No. 604 This Water Well Record was completed on (mo/day/year) 6/3/14 under the business name of Environmental Priority Service, Inc. by (signature) P. H. M. T.

INSTRUCTIONS: Use typewriter or ball point pen. PLEASE PRESS FIRMLY and PRINT clearly. Please fill in blanks and check the correct answers. Send one copy to Kansas Department of Health and Environment, Bureau of Water, Geology Section, 1000 SW Jackson St., Suite 420, Topeka, Kansas 66612-1367. Telephone 785-296-5524. Send one copy to WATER WELL OWNER and retain one for your records. Include fee of \$5.00 for each constructed well. Visit us at http://www.kdheks.gov/waterwell/index.html