


1 LOCATION OF WATER WELL: Fraction  $\frac{1}{4}$   $\frac{1}{4}$  NE  $\frac{1}{4}$  Section Number 32 Township Number T 11 S Range Number R 24 EW  
 County: Wyandotte

Distance and direction from nearest town or city street address of well if located within city?

2 WATER WELL OWNER: The Burlington Northern and Santa Fe Railway Company  
 RR#, St. Address, Box #: 4200 Deen Road Board of Agriculture, Division of Water Resources  
 City, State, ZIP Code: Fort Worth, TX 76106 Application Number:

3 LOCATE WELL'S LOCATION WITH AN "X" IN SECTION BOX:

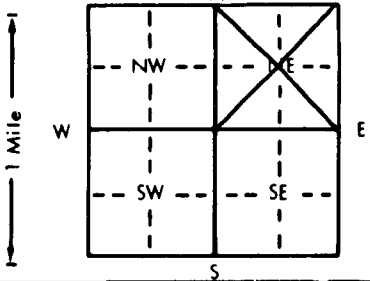

4 DEPTH OF COMPLETED WELL: 65 ft. ELEVATION:  
 Depth(s) Groundwater Encountered 1 ft. 2 ft. 3 ft.  
 WELL'S STATIC WATER LEVEL: 0 ft. below land surface measured on mo/day/yr  
 Pump test data: Well water was ft. after hours pumping gpm  
 Est. Yield gpm: Well water was ft. after hours pumping gpm  
 Bore Hole Diameter: 8 in. to 65 ft., and in. to ft.  
 WELL WATER TO BE USED AS:  
 1 Domestic 3 Feedlot 6 Oil field water supply 9 Dewatering 12 Other (Specify below)  
 2 Irrigation 4 Industrial 7 Lawn and garden only 10 Monitoring well  
 Was a chemical/bacteriological sample submitted to Department? Yes No X; If yes, mo/day/yr sample was submitted  
 Water Well Disinfected? Yes No X

5 TYPE OF BLANK CASING USED:  
 1 Steel 3 RMP (SR) 5 Wrought iron 8 Concrete tile CASING JOINTS: Glued Clamped  
 2 PVC 4 ABS 6 Asbestos-Cement 9 Other (specify below) Welded  
 7 Fiberglass Threaded X  
 Blank casing diameter: 2 in. to 55 ft., Dia in. to ft., Dia in. to ft.  
 Casing height above land surface: 30 in., weight 0.7 lbs./ft. Wall thickness or gauge No. SCH 40  
 TYPE OF SCREEN OR PERFORATION MATERIAL:  
 1 Steel 3 Stainless steel 5 Fiberglass 8 RMP (SR) 10 Asbestos-cement  
 2 Brass 4 Galvanized steel 6 Concrete tile 9 ABS 11 Other (specify)  
 12 None used (open hole)  
 SCREEN OR PERFORATION OPENINGS ARE:  
 1 Continuous slot 3 Mill slot 5 Gauzed wrapped 8 Saw cut 11 None (open hole)  
 2 Louvered shutter 4 Key punched 6 Wire wrapped 9 Drilled holes  
 7 Torch cut 10 Other (specify)  
 SCREEN-PERFORATED INTERVALS: From 55 ft. to 65 ft., From ft. to ft.  
 GRAVEL PACK INTERVALS: From 53 ft. to 65 ft., From ft. to ft.

6 GROUT MATERIAL: 1 Neat cement 2 Cement grout 3 Bentonite 4 Other  
 Grout Intervals: From 0 ft. to 46 ft., From 46 ft. to 50 ft., From ft. to ft.  
 What is the nearest source of possible contamination:  
 1 Septic tank 4 Lateral lines 7 Pit privy 10 Livestock pens 14 Abandoned water well  
 2 Sewer lines 5 Cess pool 8 Sewage lagoon 11 Fuel storage 15 Oil well/Gas well  
 3 Watertight sewer lines 6 Seepage pit 9 Feedyard 12 Fertilizer storage 16 Other (specify below)  
 13 Insecticide storage

Direction from well?

FROM	TO	LITHOLOGIC LOG	FROM	TO	PLUGGING INTERVALS
			0	5	Clay, dark gray
			5	11	Sand, brownish gray
			11	19	Clay, dark gray
			19	20	Clay w/Gravel, blackish gray
			20	60	Sand, pale brown
			60	65	Very coarse sand, pale brown

7 CONTRACTOR'S OR LANDOWNER'S CERTIFICATION: This water well was 1 constructed, (2) reconstructed, or (3) plugged under my jurisdiction and was completed on (mo/day/year) 12/24/97 and this record is true to the best of my knowledge and belief. Kansas Water Well Contractor's License No. 102 This Water Well Record was completed on (mo/day/yr) 1/20/98 under the business name of Layne Christensen Company by (signature) Nate Baldwin