

WATER WELL RECORD

Form WWC-5

Division of Water Resources App. No.

1598


Well ID

MW10

Original Record Correction Change in Well Ust

1 LOCATION OF WATER WELL: County Wyandotte Fraction NE 1/4 NW 1/4 NE 1/4 NW 1/4 Section Number 9 Township Number T 11 S Range Number R 24 E W

2 WELL OWNER: Last Name: Business: SEK, LLC Address: 11161 Overbook Rd., Suite 150 City Leawood State: KS ZIP: 66211 Street or Rural Address where well is located (if unknown, distance and direction from nearest town or intersection): If at owner's address, check here: 7517 State Ave., Kansas City, KS

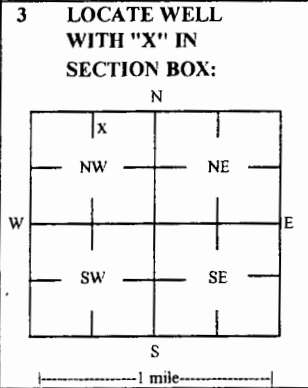

3 LOCATE WELL WITH "X" IN SECTION BOX: 4 DEPTH OF COMPLETED WELL: 30 ft Depth(s) Groundwater Encountered: 1) 30 ft 2) ft 3) ft, or 4) Dry Well WELL'S STATIC WATER LEVEL: 19.65 ft X below land surface, measured on (mo-day-yr) 8/2/17 above land surface, measured on (mo-day-yr) Pump test data: Well water was ft after hours pumping gpm Water well was ft after hours pumping gpm Estimated Yield: gpm Bore Hole Diameter: 7.25 in to ft, and in to ft

5 Latitude: 39.11598 (decimal degrees) Longitude: 94.75421 (decimal degrees) Horizontal Datum: X WGS 84 NAD 83 NAD 27 Source for Latitude/Longitude: GPS (unit make/model:) (WAAS enabled? Yes No) X Land Survey Topographic Map Online Mapper 6 Elevation 892.56 ft Ground Level TOC Source: X Land Survey GPS Topographic Map Other

7 WELL WATER TO BE USED AS: 1 Domestic: Household Lawn & Garden Livestock Irrigation Feedlot Industrial 2 Public Water Supply: well ID 3 Dewatering: how many wells? 4 Aquifer Recharge: well ID 5 Monitoring: well ID MW10 6 Environmental Remediation: well ID Air Sparge Soil Vapor Extractor Recovery Injection 7 Oil Field Water Supply: lease 8 Test Hole: well ID Cased Uncased Geotechnical 9 Geothermal: How many bores? a) Closed Loop Horizontal Vertical b) Open Loop Surface Discharge Inj. of Water Other (specify):

Was a chemical/bacteriological sample submitted to KDHE? Yes No X No If yes, date sample was submitted: Water well disinfected? Yes No X No

8 TYPE OF CASING USED: Steel PVC X Other CASING JOINTS: Glued Clamped Welded X Threaded Casing diameter 2 in. to 10 ft, Diameter in. to ft, Diameter in. to ft, Casing height above land surface -0.41 in. Weight lbs./ft. Well thickness or gauge No TYPE OF SCREEN OR PERFORATION MATERIAL: Steel Stainless Steel Fiberglass PVC X Other (Specify) Brass Galvanized Steel Concrete tile None used (open hole) SCREEN OR PERFORATION OPENINGS ARE: Continuous Slot X Mill Slot Gauze Wrapped Torch Cut Drilled Holes Other (Specify) Louvered Shutter Key Punched Wire Wrapped Saw Cut None (Open Hole) SCREEN-PERFORATED INTERVALS: From 10 ft. to 30 ft, From ft. to ft, From ft. to ft, GRAVEL PACK INTERVALS: From 8 ft. to 30 ft, From ft. to ft, From ft. to ft,

9 GROUT MATERIAL: Neat cement Cement grout Bentonite X Other Concrete: 0-1' Grout intervals: From 1 ft. to 8 ft, From ft. to ft, From ft. to ft,

Nearest source of possible contamination: Septic Tank Lateral Lines Pit Privy Livestock Pens Insecticide Storage Sewer Lines Cess Pool Sewage Lagoon X Fuel Storage Abandoned Water Well Watertight Sewer Lines Seepage Pit Feedyard Fertilizer Storage Oil Well / Gas Well Other (Specify): Direction from well? NW Distance from well? ~430 ft

Table with 6 columns: FROM, TO, LITHOLOGIC LOG, FROM, TO, LITHO. LOG (cont.) or PLUGGING INTERVALS. Rows: 0-13 Topsoil: Silty clay; 13-19 Broken limestone; 19-21 Consolidated limestone; 21-25 Shale

Notes: KDHE ID: Smokes Plus Inc.; U4-105-14816 Target of monitoring well is shallow groundwater, <20' of grout was installed at the direction of KDHE.

11 CONTRACTOR'S OR LANDOWNER'S CERTIFICATION: This water well was X constructed, reconstructed, or plugged under my jurisdiction and was completed on (mo-day-year) 7/31/17 and this record is true to the best of my knowledge and belief. License No 757 This Water Well Record was completed on (mo-day-year) 8/30/17 under the business name of Larsen & Associates, Inc. Signature

DENNIS L HANDKE

1820 NW 59th Terrace
TOPEKA, KANSAS 66618
785-286-4047 Home
785-217-5864 Cell

Jess Chapman
Larsen & Associates
1311 E. 25th Street, Suite B
Lawrence, Kansas, 66046

August 10, 2017

RE: Monitor Well Elevation Survey
7552 State Avenue, Kansas City, Kansas

Proj. 17-00Y
Smokes Plus Inc.
U4-105-14816

Bnch Mark: Chisled Sq. on SW corner of concrete light base at Southeast corner of property.
Elev: 905.66 South 52 West 3544 (from SE Cor. Sec. 4-11-24E)


MW-8	rim	895.82	South	296	NW1/4,NW1/4,NE1/4,NW1/4 (Sec. 9-11-24)
	top pipe	895.46	West	3415	Lat= 39.11602 Long = 94.75461
MW-9	rim	895.10	South	211	NE1/4,NW1/4,NE1/4,NW1/4 (Sec. 9-11-24)
	top pipe	894.62	West	3298	Lat= 39.11626 Long = 94.75419
MW-10	rim	892.97	North	310	NE1/4,NW1/4,NE1/4,NW1/4 (Sec. 9-11-24)
	top pipe	892.56	West	3302	Lat= 39.11598 Long = 94.75421

Elevation derived from existing project.

Lat & Long derived from Edwardsville 7.5' Quad Maps WGS 84.

If you have any questions, please feel free to call me. Thank you for the opportunity to be of service to you.

Dennis L Handke RLS

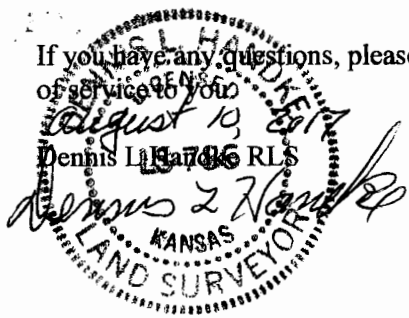

RECEIVED
SEP 12 2017
BUREAU OF WATER