

**WATER WELL RECORD Form WWC-5**

Division of Water Resources App. No.  

Well ID   MW-6

Original Record  Correction  Change in Well Use

<b>1 LOCATION OF WATER WELL:</b> County: Wyandotte	Fraction NW¼ SE¼ NE¼ NW¼	Section Number 27	Township Number T 11 S	Range Number R 24 <input checked="" type="checkbox"/> E <input type="checkbox"/> W
<b>2 WELL OWNER:</b> Last Name: Perry Business: Perry & Perry, LLC Address: 2800 W. 118th Street Address: City: Leawood State: KS ZIP: 66211		First: Frank Street or Rural Address where well is located (if unknown, distance and direction from nearest town or intersection): If at owner's address, check here: <input type="checkbox"/> 6666 Inland Drive, Kansas City, KS 66106		

<b>3 LOCATE WELL WITH "X" IN SECTION BOX:</b> N <table style="width: 100%; text-align: center; border-collapse: collapse;"> <tr><td style="border: 1px solid black; width: 20px; height: 20px;"> </td><td style="border: 1px solid black; width: 20px; height: 20px;"> </td><td style="border: 1px solid black; width: 20px; height: 20px;"> </td></tr> </table> W <span style="margin-left: 100px;">E</span> S <div style="text-align: center; border-top: 1px solid black; width: 100px; margin: 0 auto;"> <span style="font-size: small;">-----1 mile-----</span> </div>										<b>4 DEPTH OF COMPLETED WELL:</b> ...40.10... ft. Depth(s) Groundwater Encountered: 1) ..... ft. 2) ..... ft. 3) ..... ft., or 4) <input type="checkbox"/> Dry Well WELL'S STATIC WATER LEVEL: ..... 33.06 ..... ft. <input checked="" type="checkbox"/> below land surface, measured on (mo-day-yr) 01-06-20 <input type="checkbox"/> above land surface, measured on (mo-day-yr) ..... Pump test data: Well water was ..... ft. after ..... hours pumping ..... gpm Well water was ..... ft. after ..... hours pumping ..... gpm Estimated Yield: ..... gpm Bore Hole Diameter: ...8.25... in. to ...40.10... ft. and ..... in. to ..... ft.	<b>5 Latitude:</b> ..... 39.070664 ..... (decimal degrees) <b>Longitude:</b> ..... 94.734725 ..... (decimal degrees) Horizontal Datum: <input type="checkbox"/> WGS 84 <input type="checkbox"/> NAD 83 <input type="checkbox"/> NAD 27 Source for Latitude/Longitude: <input type="checkbox"/> GPS (unit make/model: .....) (WAAS enabled? <input type="checkbox"/> Yes <input type="checkbox"/> No) <input type="checkbox"/> Land Survey <input type="checkbox"/> Topographic Map <input checked="" type="checkbox"/> Online Mapper: Google Earth  <b>6 Elevation:</b> 767 ..... ft. <input checked="" type="checkbox"/> Ground Level <input type="checkbox"/> TOC Source: <input type="checkbox"/> Land Survey <input type="checkbox"/> GPS <input type="checkbox"/> Topographic Map <input checked="" type="checkbox"/> Other Google Earth

**7 WELL WATER TO BE USED AS:**

1. Domestic: <input type="checkbox"/> Household <input type="checkbox"/> Lawn & Garden <input type="checkbox"/> Livestock 2. <input type="checkbox"/> Irrigation 3. <input type="checkbox"/> Feedlot 4. <input type="checkbox"/> Industrial	5. <input type="checkbox"/> Public Water Supply: well ID ..... 6. <input type="checkbox"/> Dewatering: how many wells? ..... 7. <input type="checkbox"/> Aquifer Recharge: well ID ..... 8. <input checked="" type="checkbox"/> Monitoring: well ID MW-6 9. Environmental Remediation: well ID ..... <input type="checkbox"/> Air Sparge <input type="checkbox"/> Soil Vapor Extraction <input type="checkbox"/> Recovery <input type="checkbox"/> Injection	10. <input type="checkbox"/> Oil Field Water Supply: lease ..... 11. Test Hole: well ID ..... <input type="checkbox"/> Cased <input type="checkbox"/> Uncased <input type="checkbox"/> Geotechnical 12. Geothermal: how many bores? ..... a) Closed Loop <input type="checkbox"/> Horizontal <input type="checkbox"/> Vertical b) Open Loop <input type="checkbox"/> Surface Discharge <input type="checkbox"/> Inj. of Water 13. <input type="checkbox"/> Other (specify): .....
---	--	---

Was a chemical/bacteriological sample submitted to KDHE?  Yes  No If yes, date sample was submitted: .....  
 Water well disinfected?  Yes  No


**8 TYPE OF CASING USED:**  Steel  PVC  Other ..... CASING JOINTS:  Glued  Clamped  Welded  Threaded  
 Casing diameter ..... 2.0 ..... in. to ..... 20.10 ..... ft., Diameter ..... in. to ..... ft., Diameter ..... in. to ..... ft.  
 Casing height above land surface ..... 9.00 ..... in. Weight ..... lbs./ft. Wall thickness or gauge No. Sch. 40  
**TYPE OF SCREEN OR PERFORATION MATERIAL:**  
 Steel  Stainless Steel  Fiberglass  PVC  Other (Specify) .....  
 Brass  Galvanized Steel  Concrete tile  None used (open hole)  
**SCREEN OR PERFORATION OPENINGS ARE:**  
 Continuous Slot  Mill Slot  Gauze Wrapped  Torch Cut  Drilled Holes  Other (Specify) .....  
 Louvered Shutter  Key Punched  Wire Wrapped  Saw Cut  None (Open Hole)  
**SCREEN-PERFORATED INTERVALS:** From 20.10 ft. to 40.10 ft., From ..... ft. to ..... ft., From ..... ft. to ..... ft.  
**GRAVEL PACK INTERVALS:** From 18 ft. to 40.10 ft., From ..... ft. to ..... ft., From ..... ft. to ..... ft.

**9 GROUT MATERIAL:**  Neat cement  Cement grout  Bentonite  Other .....  
 Grout Intervals: From ..... 2 ..... ft. to ..... 18 ..... ft., From ..... ft. to ..... ft., From ..... ft. to ..... ft.  
**Nearest source of possible contamination:**  
 Septic Tank  Lateral Lines  Pit Privy  Livestock Pens  Insecticide Storage  
 Sewer Lines  Cess Pool  Sewage Lagoon  Fuel Storage  Abandoned Water Well  
 Watertight Sewer Lines  Seepage Pit  Feedyard  Fertilizer Storage  Oil Well/Gas Well  
 Other (Specify) Former used oil above ground tank .....  
 Direction from well? Northeast Distance from well? 56 ..... ft.

10 FROM	TO	LITHOLOGIC LOG	FROM	TO	LITHO. LOG (cont.) or PLUGGING INTERVALS
0	1	Asphalt/gravel			
1	8.5	Shaly fill			
8.5	11	Silty clay			
11	32	Silty fine sand with some clay			
32	40.10	Fine grained moderately well sorted sand			

Notes:

**11 CONTRACTOR'S OR LANDOWNER'S CERTIFICATION:** This water well was  constructed,  reconstructed, or  plugged under my jurisdiction and was completed on (mo-day-year) 12-16-19 ..... and this record is true to the best of my knowledge and belief. Kansas Water Well Contractor's License No. .... 75.7 ..... This Water Well Record was completed on (mo-day-year) ..... under the business name of ..... Larsen & Assoc. .... Signature

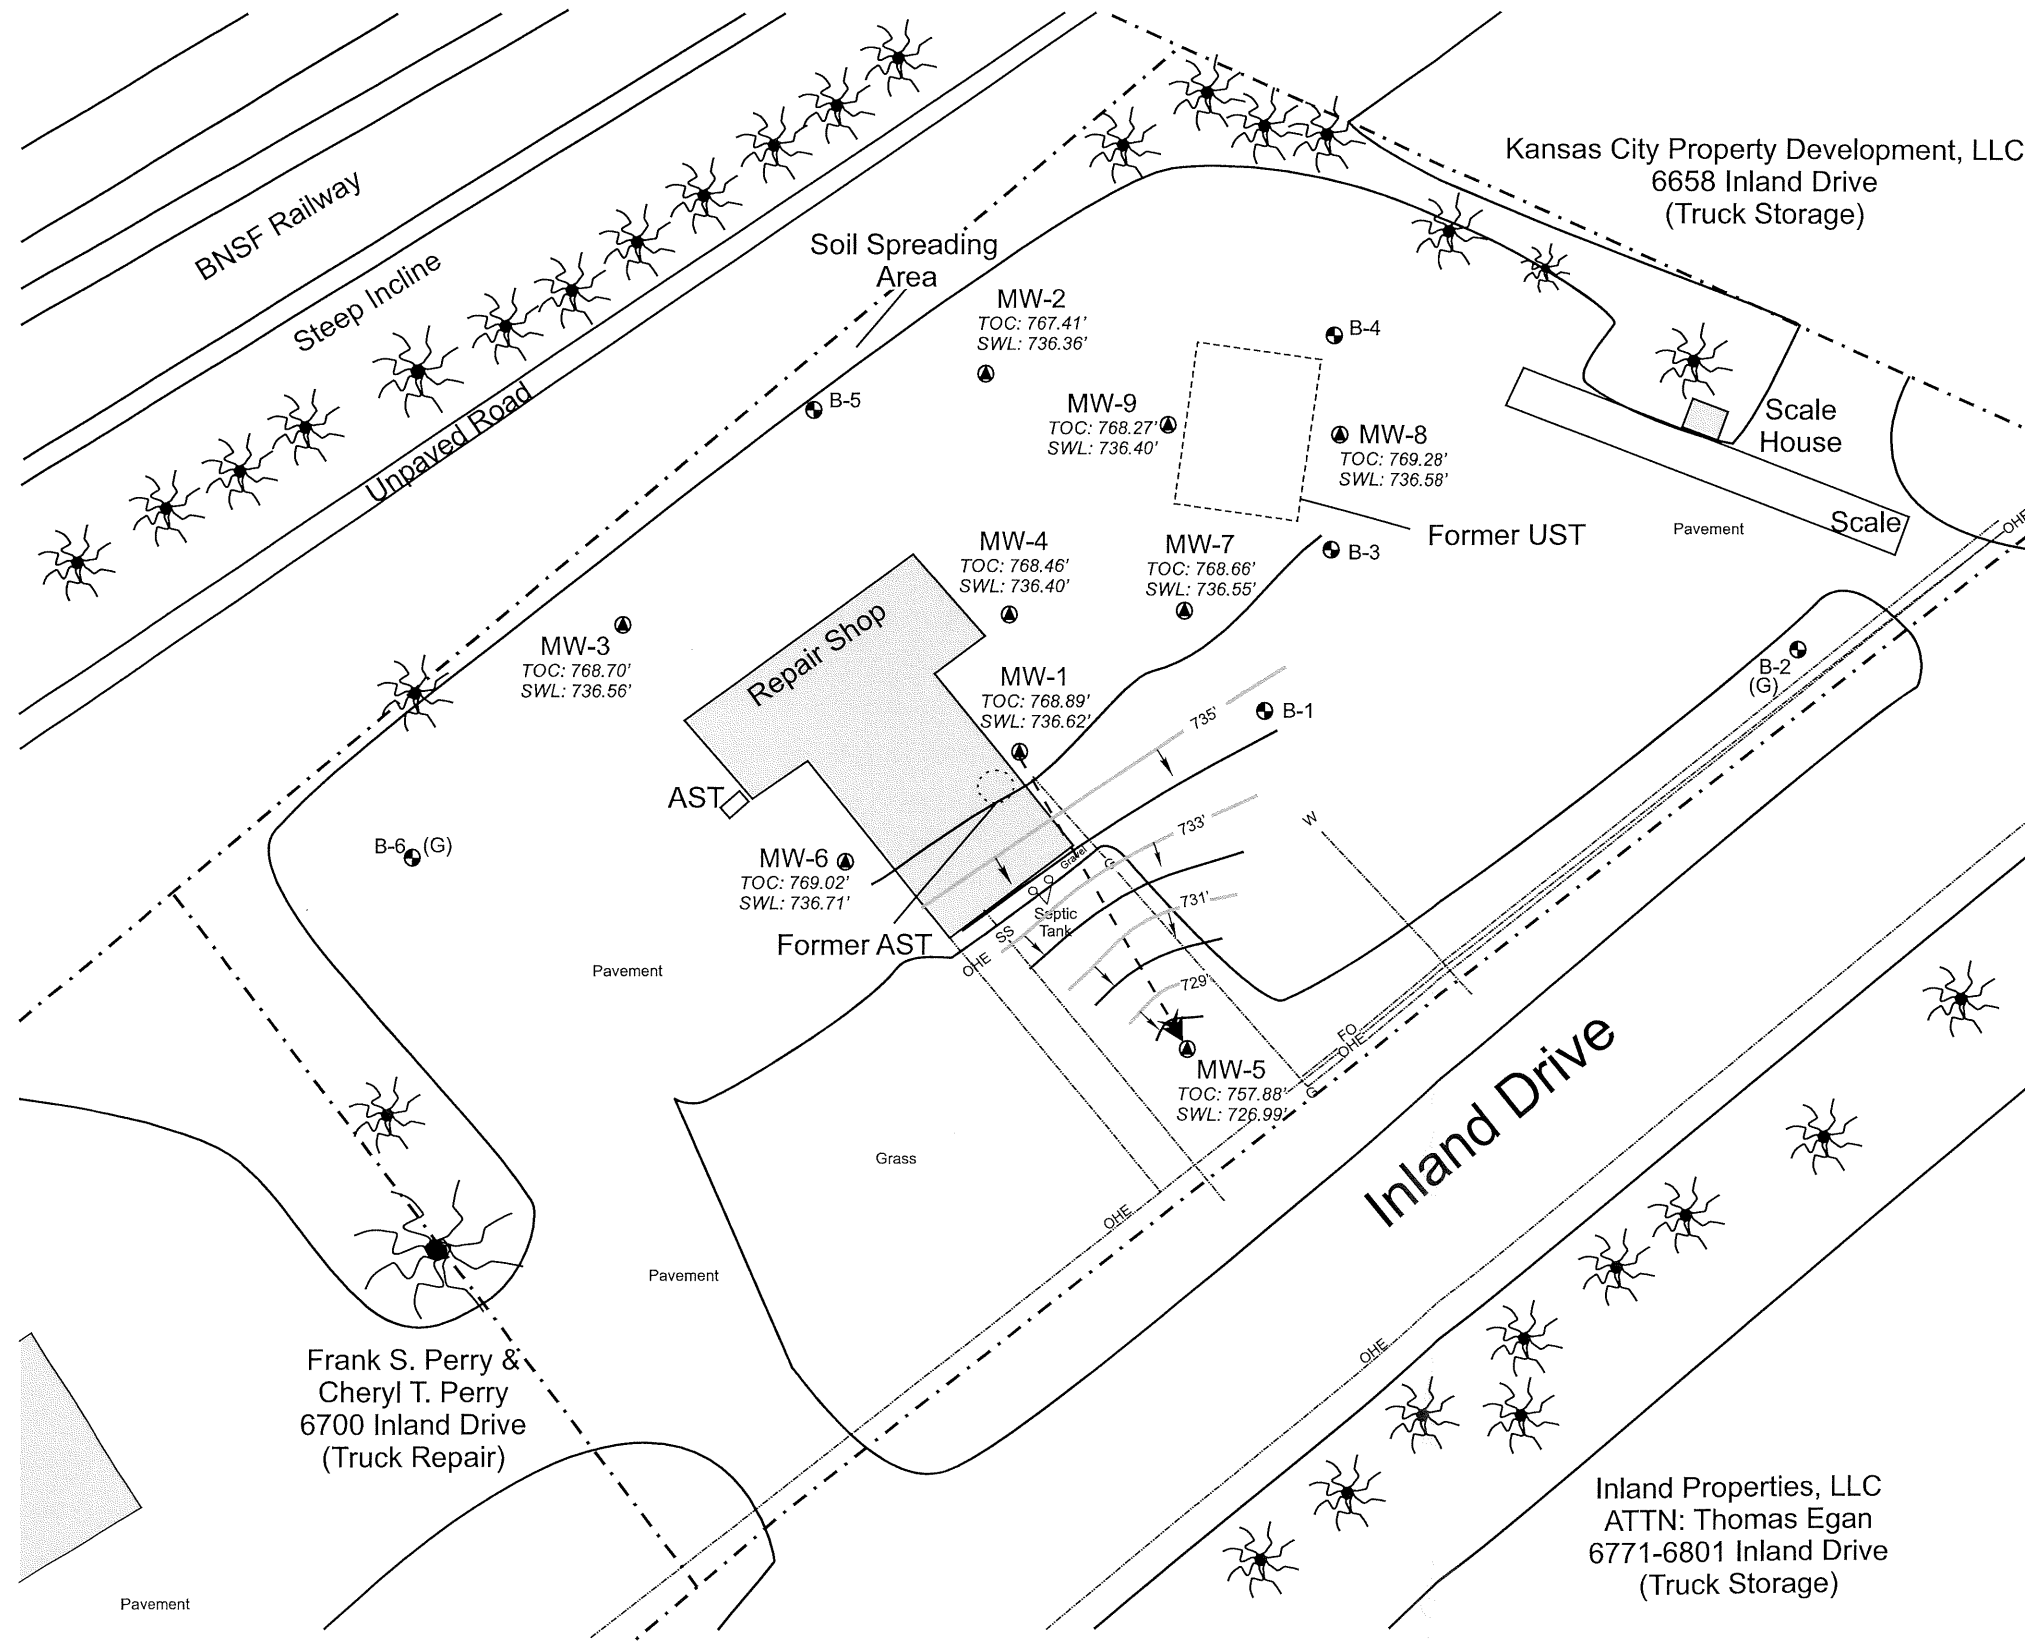

**Notes:**

- Contour interval - 1.0 foot
  - Contours generated by a linear interpretation of available data.
  - Data used in construction of this map collected January 6, 2020
  - Soil Boring Location (borings denoted with (G) for hydrologic samples)
  - Monitoring Well
  - Product Line Location
  - UST Location
  - 🌳 Tree (approx.)
  - Property Boundary
  - SS Buried Sanitary Sewer Line (3' - 5' depth, approx.)
  - G Buried Gas Line (3' - 5' depth, approx.)
  - OHE Overhead Electric, Cable, & Telephone Line (15' ave height, approx.)
  - FO Buried Fiber Optic Line (3' - 5' depth, approx.)
  - ← Hydraulic gradient flow line
- All wells for site owned by Perry & Perry, LLC

Inferred Groundwater Flow Direction

<p>Knightly Environmental Incorporated Lenexa, Kansas</p>	KEI Job No.: 69-061901-58
	Date: 01/23/20
Figure 3	
<p>Don's Fuel Stop 6666 Inland Drive Kansas City, Kansas KDHE Project A4-105-40492</p>	
<p><b>Groundwater Flow Map</b></p>	
<p>Note: Scale Approximate</p>	

Frank S. Perry & Cheryl T. Perry  
6700 Inland Drive  
(Truck Repair)

Inland Properties, LLC  
ATTN: Thomas Egan  
6771-6801 Inland Drive  
(Truck Storage)