


NOTE: Figures exhibited within this report are only to be used within the context of this report. Placement of property lines, wells, structures, and roads is based on the available information from county appraiser maps, surveys, site visits, and/or previous vendor reports and should be considered approximate.

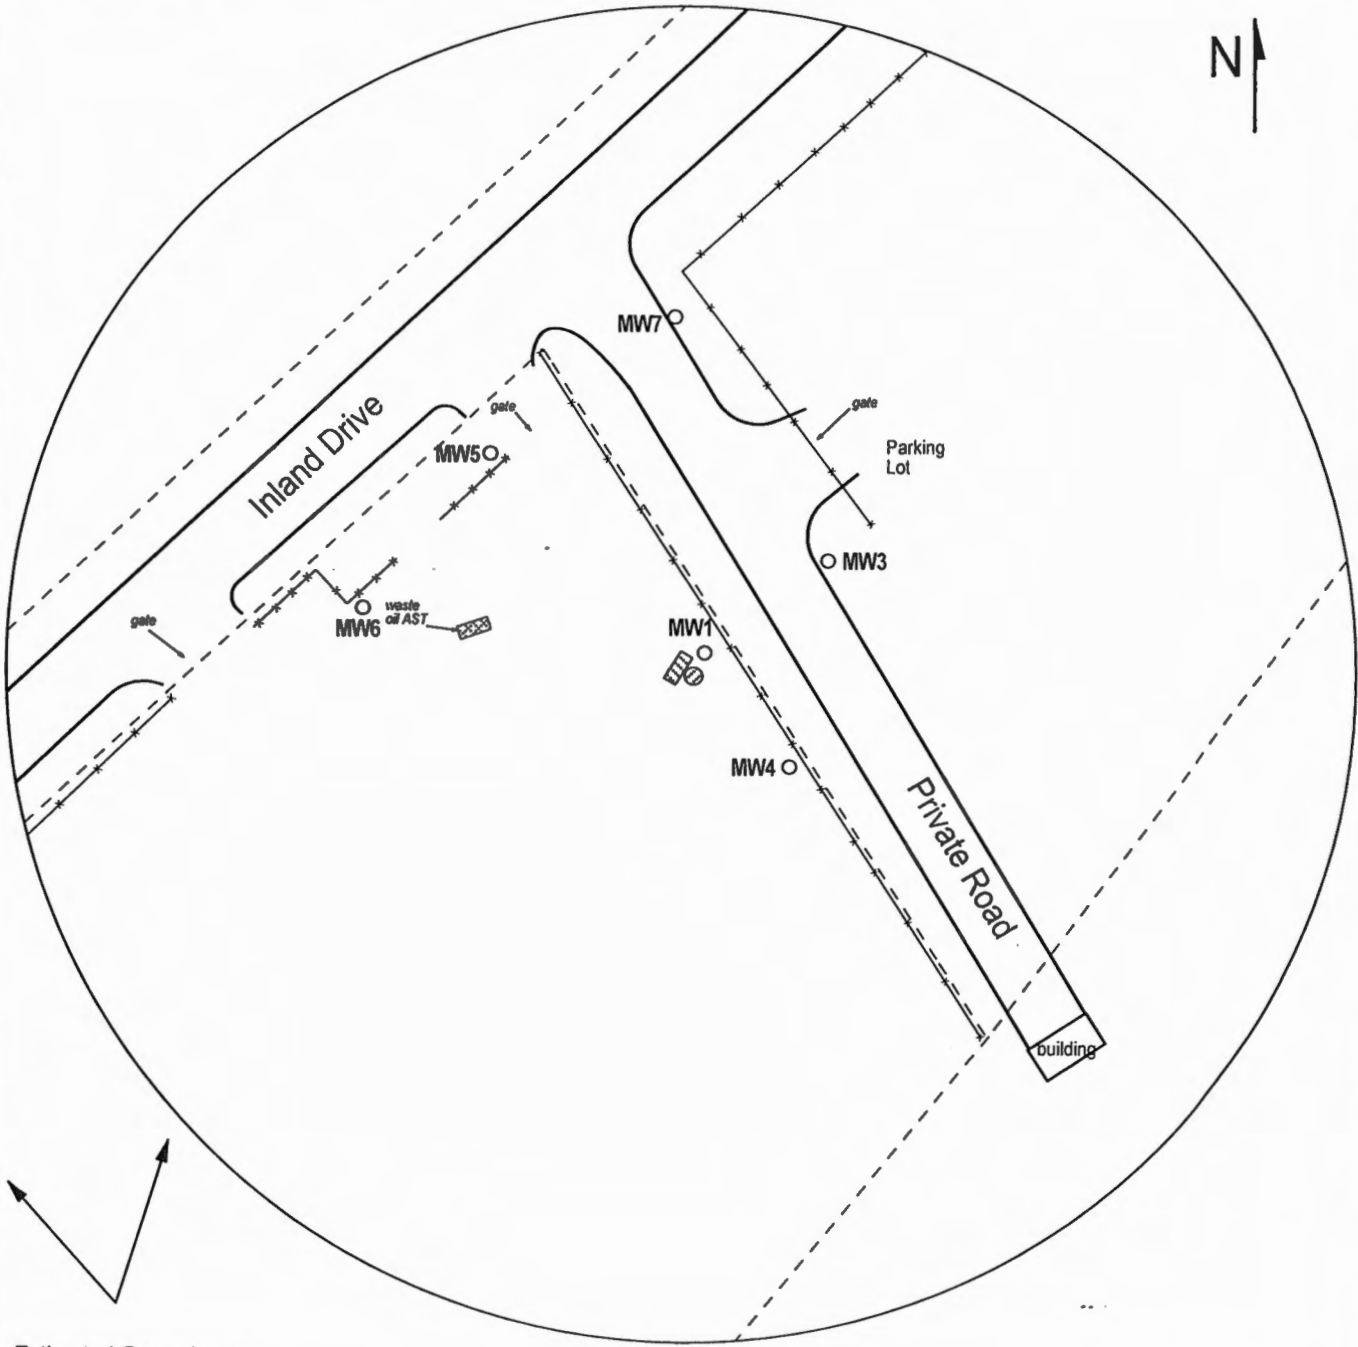

Estimated Groundwater
Flow Direction

FIGURE 1 - SITE BASE MAP



PROJECT:
The Asphalt Sales Company
6901 Inland Dr.
Kansas City, KS
KDHE ID: A4-105-40483
Date: 9/23/21

LEGEND:

- Approximate Location of Former AST
- Approximate Location of Active AST
- Approximate Location of Property Line
- Plugged Monitoring Well

RECEIVED
OCT 12 2021
BUREAU OF WATER

1311 E 25th St., Suite B (785) 841-8707 office
Lawrence, KS 66046 (785) 865-4282 fax

