

WATER WELL RECORD

Form WWC-5

Division of Water Resources App. No.

[Empty box]


Well ID

MW5

Original Record [] Correction [X] Change in Well Ust []

1 LOCATION OF WATER WELL: County Wyandotte Fraction SE 1/4 NW 1/4 NW 1/4 NE 1/4 Section Number 8 Township Number T 11 S Range Number R 24 [X] E [] W

2 WELL OWNER: Last Name: Business: KDHE Address: 1000 SW Jackson St City: Topeka State: KS ZIP: 66612 Street or Rural Address where well is located (if unknown, distance and direction from nearest town or intersection): 1000 N 82nd St. Kansas City, KS 66112

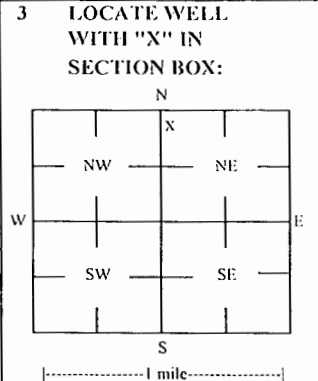

3 LOCATE WELL WITH "X" IN SECTION BOX: 4 DEPTH OF COMPLETED WELL: 38.5 ft Depth(s) Groundwater Encountered: 1) 2) 3) 4) [] Dry Well WELL'S STATIC WATER LEVEL: 27.3 ft [X] below land surface, measured on (mo-day-yr) 1/27/2022 [] above land surface, measured on (mo-day-yr) Pump test data: Well water was after hours pumping gpm Water well was after hours pumping gpm Estimated Yield: gpm Bore Hole Diameter: 8.25 in to ft, and in to ft

5 Latitude: 39.11512 (decimal degrees) Longitude: 94.76960 (decimal degrees) Horizontal Datum: [X] WGS 84 [] NAD 83 [] NAD 27 Source for Latitude/Longitude: [] GPS (unit make/model:) (WAAS enabled? [] Yes [] No) [X] Land Survey [] Topographic Map [] Online Mapper 6 Elevation 960.01 ft [] Ground Level [X] TOC Source: [X] Land Survey [] GPS [] Topographic Map [] Other

7 WELL WATER TO BE USED AS: 1 Domestic: [] Household [] Lawn & Garden [] Livestock [] Irrigation [] Feedlot [] Industrial 2 Public Water Supply: well ID 3 Dewatering: how many wells? 4 Aquifer Recharge: well ID 5 Monitoring: well ID MW5 6 Environmental Remediation: well ID 7 Air Sparge [] Soil Vapor Extractor 8 Recovery [] Injection 9 Oil Field Water Supply: lease 10 Test Hole: well ID [] Cased [] Uncased [] Geotechnical 11 Geothermal: How many bores? a) Closed Loop [] Horizontal [] Vertical b) Open Loop [] Surface Discharge [] Inj. of Water [] Other (specify):

Was a chemical/bacteriological sample submitted to KDHE? [] Yes [X] No If yes, date sample was submitted: Water well disinfected? [] Yes [X] No

8 TYPE OF CASING USED: [] Steel [X] PVC [] Other CASING JOINTS: [] Glued [] Clamped [] Welded [X] Threaded Casing diameter 2 in. to 28.5 ft. Diameter in. to ft, Diameter in. to ft, Casing height above land surface -0.44 in. Weight lbs./ft. Well thickness or gauge No TYPE OF SCREEN OR PERFORATION MATERIAL: [] Steel [] Stainless Steel [] Fiberglass [X] PVC [] Other (Specify) [] Brass [] Galvanized Steel [] Concrete tile [] None used (open hole) SCREEN OR PERFORATION OPENINGS ARE: [] Continuous Slot [X] Mill Slot [] Gauze Wrapped [] Torch Cut [] Drilled Holes [] Other (Specify) [] Louvered Shutter [] Key Punched [] Wire Wrapped [] Saw Cut [] None (Open Hole) SCREEN-PERFORATED INTERVALS: From 28.5 ft. to 38.5 ft, From ft. to ft, From ft. to ft, GRAVEL PACK INTERVALS: From 26.5 ft. to 38.5 ft, From ft. to ft, From ft. to ft.

9 GROUT MATERIAL: [] Neat cement [] Cement grout [X] Bentonite [X] Other Concrete: 0-0.7' Grout intervals: From 0.7 ft. to 26.5 ft, From ft. to ft, From ft. to ft.

Nearest source of possible contamination: [] Septic Tank [] Lateral Lines [] Pit Privy [] Livestock Pens [] Insecticide Storage [] Sewer Lines [] Cess Pool [] Sewage Lagoon [] Fuel Storage [] Abandoned Water Well [] Watertight Sewer Lines [] Seepage Pit [] Feedyard [] Fertilizer Storage [] Oil Well / Gas Well [X] Other (Specify) Dry cleaning Direction from well? NE Distance from well? ~220 ft

Table with 6 columns: FROM, TO, LITHOLOGIC LOG, FROM, TO, LITHO. LOG (cont.) or PLUGGING INTERVALS. Rows include Asphalt, Gravel fill, Clay, Fatty clay, Silty clay grading to silty sand, Sandstone, Clay grading to silt, Bedrock. Notes: KDHE ID: Norge Village / Excel Cleaners C4-105-73681/73680 Target of monitoring well is shallow groundwater, <20' of grout was installed at the direction of KDHE.

11 CONTRACTOR'S OR LANDOWNER'S CERTIFICATION: This water well was [X] constructed, [] reconstructed, or [] plugged under my jurisdiction and was completed on (mo-day-year) 12/13/21 and this record is true to the best of my knowledge and belief. Kansas Water Well Contractor's License No 757 This Water Well Record was completed on (mo-day-year) 2/15/22 under the business name of Larsen & Associates, Inc. Signature

Wyandotte

8-11-24E

DENNIS L HANDKE

1820 NW 59th Terrace
TOPEKA, KANSAS 66618
785-286-4047 Home

Jess Chapman
Larsen & Assoc.
1311 E. 25th St., Suite B
Lawrence, Kansas 66046

January 27, 2022

RE: Monitor Well Elevation Survey
8129 State Ave, Kansas City, Kansas

Proj. 22-00D
North Village Cleaners
KDHE ID U4-105-73681

Bench Mark: Chisled X on top SW bolt on concrete parking lot light base #3.

Elev.: 967.83 North 5157.15 West 2137.54 (from SE Cor. Sec. 8-11-24E)

MW-1	rim	965.21	North	5172.27	NW1/4,NW1/4,NW1/4,NE1/4
	top pipe	964.59	West	2312.03	Lat = 39.11607 Long = 94.76867
MW-2	rim	953.51	North	4987.06	NW1/4,NE1/4,NW1/4,NE1/4
	top pipe	953.06	West	1775.92	Lat = 39.11571 Long = 94.76704
MW-3	rim	966.09	North	4881.73	SW1/4,NW1/4,NW1/4,NE1/4
	top pipe	965.63	West	2360.75	Lat = 39.11656 Long = 94.76579
MW-4	rim	966.67	North	4878.30	SW1/4,NE1/4,NW1/4,NE1/4
	top pipe	966.31	West	1865.24	Lat = 39.11527 Long = 94.76884
MW-5	rim	960.45	North	4828.02	SE1/4,NW1/4,NW1/4,NE1/4
	top pipe	960.01	West	2576.13	Lat = 39.11512 Long = 94.76960
MW-6	rim	958.11	North	4722.05	SW1/4,NW1/4,NW1/4,NE1/4
	top pipe	957.74	West	2483.26	Lat = 39.11483 Long = 94.76927
MW-7	rim	963.31	North	4798.02	SE1/4,NE1/4,NW1/4,NE1/4
	top pipe	962.96	West	1608.02	Lat = 39.11504 Long = 94.76619
MW-8	rim	946.27	North	4944.67	SE1/4,NE1/4,NW1/4,NE1/4
	top pipe	946.03	West	1417.53	Lat = 39.11545 Long = 94.76552

Lat & Long derived from Edwardsville 7.5' quad map. WGS84.

Elevation derived from Kansas City Public Works, NAVD 88.

If you have any questions, please feel free to call me. Thank you for the opportunity to be

RECEIVED

MAY 25 2022

BUREAU OF WATER

