
WATER WELL PLUGGING RECORD	Form WWC-5P	KSA 82a-1212	ID NO.	MWIA
1 LOCATION OF WATER WELL: County: Wyandotte	Fraction 1/4 SW 1/4 SW 1/4 N	Section Number 22	Township Number T 11 S	Range Number 24 X E W
Street/Rural Address of Well Location; if unknown, distance & Global Positioning Systems (GPS) information:				
direction from nearest town or intersection: If at	Latitude: NA	systems (OI S) mior ma	(in decimal degrees)	
check here		Longitude: NA		(in decimal degrees)
		Elevation: NA		
901 S. 66th Ter., Kansas City, KS		Horizontal Datum	WGS84, NA	AD83, NAD27
2 WATER WELL CHIEFE		Collection Method:		
	orton Solvents, Inc. 01 S 66th Ter.	GPS unit (Mak Digital Map/Pho		Land Survey
The second secon	sas City, KS	Digital Wap/t lio	to, Topograpine Wap	Dana Survey
	•	Est. Accuracy:	<3 m, 3-5 m,]5-15 m,
3 MARK WELL'S LOCATION	4 DEPTH OF WE	LL55	ft.	
WITH AN "X" IN SECTION BOX:	WELL'S STATIC WATER LEVEL NA ft			
WELL WAS USED AS:				
NW NE	Domestic	Public Wate	er Supply	Dewatering
w x E	Irrigation	Oil Field W		Monitoring
	Feedlot		awn & Garden)	Injetion Well
SW SE	Industrial Air Conditioning Other			
S	Was a chemical/bacteriological sample submitted to Department? Yes No X			
5 TYPE OF BLANK CASING USED:				
Steel RMP (SR) Wrought Fiberglass Other (Specific below) X PVC ABS Sestos-Cement Concrete Tile				
Plank assing diameter 2 in Was 1 11 10 W V V V				
Blank casing diameter 2 in. Was casing pulled? Yes X No If yes, how much 3' Casing heigh above or below land surface NA in.				
6 GROUT PLUG MATERIAL: Neat cement Cement grout X Bentonite X Other Soil: 0-0.5'				
Grout Plug Intervals: From 0.5 ft to 55 ft, From ft to ft, From ft to ft,				
What is the nearest source of possible contamination:				
Septic tank Seepage pit Fuel storage Other (specify below)				
Sewer lines Pit privy Fertilizer storage				
Watertight sewer lines Sewage lagoon Insecticide storage Lateral lines Feed yard Abandoned water well Direction from well?				
	ock pens Oil well/0		ow many feet?	
FROM TO PLUGGIN	JC MATERIAL C	FROM TO	DI LICCINI	CMATERIALC
0 0.5 Soil	NG MATERIALS	FROM TO	PLUGGIN	G MATERIALS
0.5 55 Bentonite				
		KDHE ID:	Barton Solvents; C	4-105-72660
		ADUE ID:	Darton Solvents; C	1 -103-72000
7 CONTRACTOR'S OR LANDOWNER'S CERTIFICATION: This water well was plugged under my jurisdiction and was				
completed on (mo/day/year) 6/14/2022 and this record is true to the best of my knowledge and belief. Kansas Water				
Contractor's License No. 757. This Water Well Record was completed on (mo/day/year)				
business name of Larsen & Associates, Inc. By (signature)				
Send one white copy to Kansas Department of Health & Environment, Geology Section, 1000 SW Jackson Street, Ste. 420, Topeka, KS 66612-1367. Send one copy to WATER WELL OWNER and retain one for your records				
Visit us at http://www.kdheks.gov/waterwell/index.html Telephone 785-296-5524.				
KSA82a-1212 Revise				Revised 1/20/2015

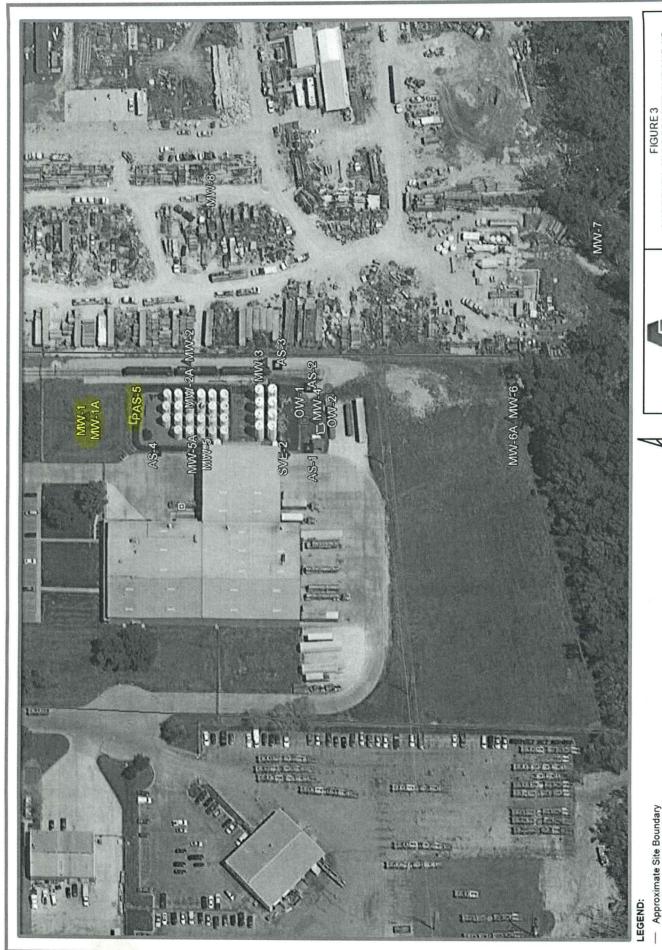

CURRENTAND PROPOSED SVEANDAS POINT LOCATIONS MAP BARTON SOLVENTS, INC. KANSAS CITY BRANCH 901 S. 66TH TERRACE KANSAS CITY, KANSAS FIGURE 3

FISHER ARNOLD

Aerial photo provided by Google Earth

SVE Well AS Well Observation Well A Monitoring Well
SVE Well
AS Well
Observation Well