
| WATER WELL PLUGGING RECORD | Form WWC-5P | KSA 82a-1212 | ID NO. | MW1 |
|---|------------------------------|--------------------------|---------------------------|-----------------------|
| | Fraction NW ¼ SE ¼ SW ¼ N | Section Number 22 | Township Number T 11 S | Range Number 24 X E W |
| Street/Rural Address of Well Location; if unknown, distance & Global Positioning Systems (GPS) information: | | | | |
| direction from nearest town or intersection: If at o | owner's address, | Latitude: NA | | (in decimal degrees) |
| check here | | Longitude: NA | | (in decimal degrees) |
| | | Elevation: NA | | |
| 901 S. 66th Ter., Kansas City, KS | | Horizontal Datum | WGS84, NA | AD83, NAD27 |
| | | Collection Method: | | |
| | ton Solvents, Inc. | GPS unit (Mak | | |
| RR#, St. Address, Box #: 901 S 66th Ter. | | Digital Map/Pho | to, Topographic Map | Land Survey |
| City, State ZIP Code: Kansa | as City, KS | F | | 15.15 |
| | | Est. Accuracy: | <pre><3 m,3-5 m,</pre> | 5-15 m, >15 m |
| 3 MARK WELL'S LOCATION | 4 DEPTH OF WE | LL 41.2 | ft. | |
| WITH AN "X" IN SECTION | | | - | |
| BOX: | WELL'S STATIC | WATER LEVEL | NA ft | |
| N WELL WAS HODD AS | | | | |
| WELL WAS USED AS: | | | | |
| I INE — | Domestic | Public Wate | er Supply | Dewatering |
| | Irrigation | Oil Field W | | Monitoring |
| W E | Feedlot | | awn & Garden) | Injetion Well |
| swse | Industrial | Air Condition | | Other |
| | | | | |
| S | Was a chemical/bac | teriological sample subm | nitted to Department? | Yes No X |
| 5 TYPE OF BLANK CASING USED: | | | | |
| | | | | |
| Steel RMP (SR) Wrought Fiberglass Other (Specific below) | | | | |
| X PVC ABS Asbestos-Cement Concrete Tile | | | | |
| Blank casing diameter 2 in. Was casing pulled? Yes X No If yes, how much 3' | | | | |
| Blank casing diameter 2 in. Was casing pulled? Yes X No If yes, how much 3' Casing heigh above or below land surface NA in. | | | | |
| | | | | |
| 6 GROUT PLUG MATERIAL: Neat cement Cement grout X Bentonite X Other Soil: 0-0.5' | | | | |
| Theat centent grout X bentonite X other soil 0-0.5 | | | | |
| Grout Plug Intervals: From 0.5 ft to 41.2 ft, From ft to ft, From ft to ft, | | | | |
| | | | | |
| What is the nearest source of possible contamination: | | | | |
| Septic tank Seepage pit Fuel storage Other (specify below) | | | | |
| Sewer lines Pit privy Fertilizer storage | | | | |
| Watertight sewer lines Sewage lagoon Insecticide storage Lateral lines Feed yard Abandoned water well Direction from well? | | | | |
| | | | | |
| Cess pool Livestock pens Oil well/Gas well How many feet? | | | | |
| FROM TO PLUGGING | G MATERIALS | FROM TO | PLUGGING | G MATERIALS |
| 0 0.5 Soil | | | | |
| 0.5 41.2 Bentonite | | | | |
| | | | | |
| | | | | |
| | | | | |
| | | KDHE ID: | Barton Solvents; Ca | 4-105-72660 |
| | | | | |
| 7 CONTRACTOR'S OR LANDOWNER'S CERTIFICATION: This water well was plugged under my jurisdiction and was | | | | |
| completed on (mo/day/year) 6/14/2022 and this record is true to the best of my knowledge and belief. Kansas Water Contractor's License No. 757. This Water Well Record was completed on (mo/day/year) 422/2022 under the | | | | |
| Contractor's License No. 757. This Water Well Record was completed on (mo/day/year) under the business name of Larsen & Associates, Inc. By (signature) | | | | |
| Send one white copy to Kansas Department of Health & Environment, Geology Section, 1000 344 Letson Street, Ste. 420, Topeka, KS | | | | |
| 66612 1267 Sand and compute WATER WELL OWNER and records | | | | |
| Visit us at http://www.kdheks.gov/waterwell/index.html Telephone 785-296-5524. | | | | |
| | | | | |

KSA82a-1212

Revised 1/20/2015

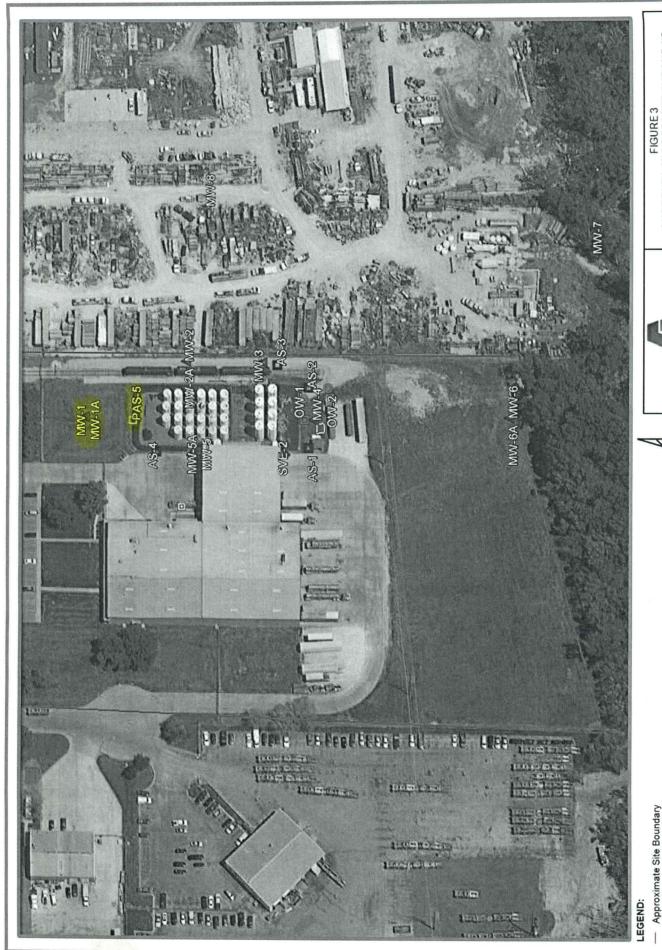

CURRENTAND PROPOSED SVEANDAS POINT LOCATIONS MAP BARTON SOLVENTS, INC. KANSAS CITY BRANCH 901 S. 66TH TERRACE KANSAS CITY, KANSAS FIGURE 3

FISHER ARNOLD

Aerial photo provided by Google Earth

SVE Well AS Well Observation Well A Monitoring Well
SVE Well
AS Well
Observation Well