
WATER WELL PLUGGING RECORD	Form WWC-5P	KSA 82a-1212	ID NO.	PAS-5
County: Wyandotte	Fraction 1/4 SW 1/4 SW 1/4 N	Section Number 22	T 11 S	Range Number 24 X E W
Street/Rural Address of Well Location; if unknown, distance & Global Positioning Systems (GPS) information:				
direction from nearest town or intersection: If at check here		Latitude: NA Longitude: NA Elevation: NA		(in decimal degrees) (in decimal degrees)
901 S. 66th Ter., Kansas City, KS		Horizontal Datum WGS84, NAD83, NAD27 Collection Method:		
RR#, St. Address, Box #: 90	rton Solvents, Inc. 1 S 66th Ter. sas City, KS	GPS unit (Ma Digital Map/Pho Est. Accuracy:		
3 MARK WELL'S LOCATION	4 DEPTH OF WE	LL55	ft.	
WITH AN "X" IN SECTION BOX:	WELL'S STATIC	WATER LEVEL _	NA ft	
N N				
NW NE	Domestic	Public Water		Dewatering
W X E	Feedlot Domestic (Lawn & Garden) SE Industrial Air Conditioning Other Industrial Oil Field Water Supply X Monitoring Injetion Well Other			
	Was a chemical/bacteriological sample submitted to Department? Yes NoX			
5 TYPE OF BLANK CASING USED:				
Steel RMP (SR) Wrought Fiberglass Other (Specific below) X PVC ABS Concrete Tile				
Blank casing diameter 2 in. Was casing pulled? Yes X No If yes, how much 3' Casing heigh above or below land surface NA in.				
6 GROUT PLUG MATERIAL: Neat cement Cement grout X Bentonite X Other Soil: 0-0.5'				
Grout Plug Intervals: From <u>0.5</u> ft to <u>55</u> ft, From ft to ft, From ft to ft,				
What is the nearest source of possible contamination: Septic tank Seepage pit Fuel storage Other (specify below)				
Sewer lines Pit privy Fertilizer storage Watertight sewer lines Sewage lagoon Insecticide storage				
Lateral lines Cess pool Feed yard Livestock pens Abandoned water well Oil well/Gas well How many feet?				
FROM TO PLUGGIN 0 0.5 Soil	IG MATERIALS	FROM T	O PLUGGIN	G MATERIALS
0.5 55 Bentonite				
KDHE ID: Barton Solvents; C4-105-72660				
7 CONTRACTOR'S OR LANDOWNER'S CERTIFICATION: This water well was plugged under my jurisdiction and was				
completed on (mo/day/year) 6/14/2022 and this record is true to the best of my knowledge and tablef. Kansas Water Contractor's License No. 757. This Water Well Record was completed on (mo/day/year) 6/22/2022 under the				
business name of Larsen & Associates, Inc. By (signature) Send one white copy to Kansas Department of Health & Environment, Geology Section, 1000 SW Jackson Street, Ste. 420, Topeka, KS				
66612-1367. Send one copy to WATER WELL OWNER and retain one for your records Visit us at http://www.kdheks.gov/waterwell/index.html Telephone 785-296-5524.				

KSA82a-1212

Revised 1/20/2015

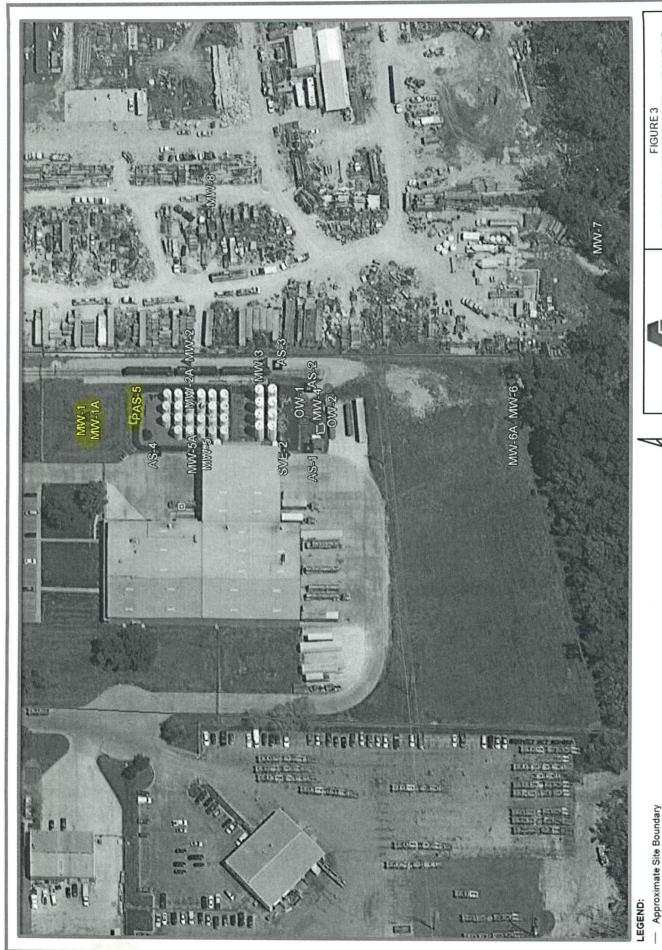

CURRENTAND PROPOSED SVEANDAS POINT LOCATIONS MAP BARTON SOLVENTS, INC. KANSAS CITY BRANCH 901 S. 66TH TERRACE KANSAS CITY, KANSAS FIGURE 3

FISHER ARNOLD

Aerial photo provided by Google Earth

SVE Well AS Well Observation Well A Monitoring Well
SVE Well
AS Well
Observation Well