


1 LOCATION OF WATER WELL: County: Wyandotte Fraction: SE 1/4 SW 1/4 Section Number: 4 Township Number: T 11 S Range Number: R 24 E/W

Distance and direction from nearest town or city street address of well if located within city?
7677 State Ave Kansas City, KS

2 WATER WELL OWNER: Jay Wolfe Honda Board of Agriculture, Division of Water Resources
 RR#, St. Address, Box #: 7677 State Ave Application Number:
 City, State, ZIP Code: Kansas City, KS 66112

3 LOCATE WELL'S LOCATION WITH AN "X" IN SECTION BOX: 4 DEPTH OF COMPLETED WELL: 7'-10" ft. ELEVATION: 940

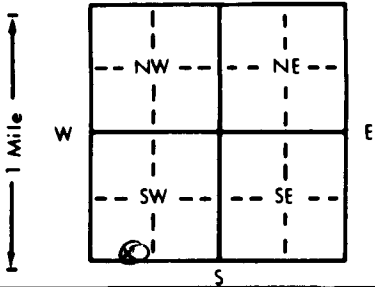

Depth(s) Groundwater Encountered 1. N/A ft. 2. ft. 3. ft.
 WELL'S STATIC WATER LEVEL dry ft. below land surface measured on mo/day/yr
 Not Tested Pump test data: Well water was ft. after hours pumping gpm
 Est. Yield gpm Well water was ft. after hours pumping gpm
 Bore Hole Diameter: 6 1/4 in. to 8 ft., and in. to ft.
 WELL WATER TO BE USED AS: 5 Public water supply 8 Air conditioning 11 Injection well
 1 Domestic 3 Feedlot 6 Oil field water supply 9 Dewatering 12 Other (Specify below)
 2 Irrigation 4 Industrial 7 Lawn and garden only 10 Monitoring well Vapor Monitor
 Was a chemical/bacteriological sample submitted to Department? Yes No; If yes, mo/day/yr sample was submitted
 Water Well Disinfected? Yes No

5 TYPE OF BLANK CASING USED: None 5 Wrought iron 8 Concrete tile CASING JOINTS: Glued Clamped
 1 Steel 3 RMP (SR) Used 6 Asbestos-Cement 9 Other (specify below) Welded
 2 PVC 4 ABS 7 Fiberglass Threaded

Blank casing diameter: N/A in. to ft., Dia. in. to ft., Dia. in. to ft.
 Casing height above land surface: 0 in., weight lbs./ft. Wall thickness or gauge No.

TYPE OF SCREEN OR PERFORATION MATERIAL: 7 PVC 10 Asbestos-cement
 1 Steel 3 Stainless steel 5 Fiberglass 8 RMP (SR) 11 Other (specify)
 2 Brass 4 Galvanized steel 6 Concrete tile 9 ABS 12 None used (open hole)

SCREEN OR PERFORATION OPENINGS ARE: 5 Gauzed wrapped 8 Saw cut 11 None (open hole)
 1 Continuous slot 3 Mill slot 6 Wire wrapped 9 Drilled holes
 2 Louvered shutter 4 Key punched 7 Torch cut 10 Other (specify)

SCREEN-PERFORATED INTERVALS: From 7'-10" ft. to 0 ft., From ft. to ft.
 From ft. to ft., From ft. to ft.
 GRAVEL PACK INTERVALS: From 8 ft. to 2 ft., From ft. to ft.
 From ft. to ft., From ft. to ft.

6 GROUT MATERIAL: 1 Neat cement 2 Cement grout 3 Bentonite 4 Other
 Grout Intervals: From 2 ft. to 1 ft., From 1 ft. to 0 ft., From ft. to ft.

What is the nearest source of possible contamination:
 1 Septic tank 4 Lateral lines 7 Pit privy 11 Fuel storage 14 Abandoned water well
 2 Sewer lines 5 Cess pool 8 Sewage lagoon 12 Fertilizer storage 15 Oil well/Gas well
 3 Watertight sewer lines 6 Seepage pit 9 Feedyard 13 Insecticide storage 16 Other (specify below)

Direction from well? How many feet?

FROM	TO	LITHOLOGIC LOG	FROM	TO	PLUGGING INTERVALS
0	5.5	Grey silty Clay			
5.5	8	Red silty Clay			

7 CONTRACTOR'S OR LANDOWNER'S CERTIFICATION: This water well was (1) constructed, (2) reconstructed, or (3) plugged under my jurisdiction and was completed on (mo/day/year) 7/18/91 and this record is true to the best of my knowledge and belief. Kansas Water Well Contractor's License No. 519 This Water Well Record was completed on (mo/day/yr) 8/12/91 under the business name of West Hazmat Drilling Corp by (signature) Jay N. Jones

OFFICE USE ONLY
T
R
EW
SEC.
1/4
1/4
1/4