

LOCATION OF WATER WELL:	Fraction	Section Number	Township Number	Range Number
County: WYANDOTTE	NE 1/4 NW 1/4 NW 1/4	11	T 11 S	R 24 EW

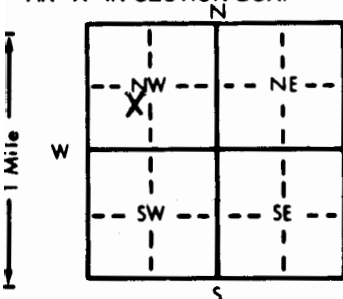
Distance and direction from nearest town or city street address of well if located within city?

746 N. 63RD K.C. KS.WATER WELL OWNER: **MARK BISHOP**RR#, St. Address, Box #: **746 N. 63RD**City, State, ZIP Code: **KANSAS CITY, KS 66102**

Board of Agriculture, Division of Water Resources

Application Number:

LOCATE WELL'S LOCATION WITH AN "X" IN SECTION BOX:

DEPTH OF COMPLETED WELL: **48** ft. ELEVATION:Depth(s) Groundwater Encountered **1. 38** ft. 2. ft. 3. ft.WELL'S STATIC WATER LEVEL **2.7** ft. below land surface measured on mo/day/yr **4/18/89**

Pump test data: Well water was ft. after hours pumping gpm

Est. Yield **1** gpm: Well water was ft. after hours pumping gpmBore Hole Diameter **10** in. to **48** ft. and in. to ft.

WELL WATER TO BE USED AS: 5 Public water supply 8 Air conditioning 11 Injection well

1 Domestic 3 Feedlot 6 Oil field water supply 9 Dewatering 12 Other (Specify below)

2 Irrigation 4 Industrial 7 Lawn and garden only 10 Observation well

Was a chemical/bacteriological sample submitted to Department? Yes No **X** If yes, mo/day/yr sample was submitted Water Well Disinfected? **Yes** No

TYPE OF BLANK CASING USED:

1 Steel 3 RMP (SR)

2 PVC 4 ABSBlank casing diameter **5** in. to **38** ft. Dia.Casing height above land surface **18** in. weight **1.5** lbs./ft. Wall thickness or gauge No. **200**

TYPE OF SCREEN OR PERFORATION MATERIAL:

1 Steel 3 Stainless steel

2 Brass 4 Galvanized steel

5 Fiberglass

6 Concrete tile

8 RMP (SR)

9 ABS

10 Asbestos-cement

11 Other (specify)

12 None used (open hole)

SCREEN OR PERFORATION OPENINGS ARE:

1 Continuous slot 3 Mill slot

2 Louvered shutter 4 Key punched

5 Gauzed wrapped

6 Wire wrapped

7 Torch cut

8 Saw cut

9 Drilled holes

10 Other (specify)

11 None (open hole)

SCREEN-PERFORATED INTERVALS:

From **48** ft. to **38** ft. From ft. to ft.From **48** ft. to **3** ft. From ft. to ft.GRAVEL PACK INTERVALS: From **48** ft. to **3** ft. From ft. to ft.

From ft. to ft. From ft. to ft.

GROUT MATERIAL:

1 Neat cement

2 Cement grout

3 Bentonite

4 Other

Grout Intervals: From **24** ft. to **3** ft. From ft. to ft. From ft. to ft.

What is the nearest source of possible contamination:

1 Septic tank 4 Lateral lines

2 Sewer lines 5 Cess pool

3 Watertight sewer lines 6 Seepage pit

7 Pit privy

8 Sewage lagoon

9 Feedyard

10 Livestock pens

11 Fuel storage

12 Fertilizer storage

13 Insecticide storage

14 Abandoned water well

15 Oil well/Gas well

16 Other (specify below)

CREEKDirection from well? **SW**How many feet? **300'**

FROM	TO	LITHOLOGIC LOG	FROM	TO	LITHOLOGIC LOG
0	2	SURFACE			
2	21	CLAY (RED)			
21	22	LIMESTONE (FLCATERS)			
22	26	BLUE MUD			
26	29	CLAY (YELLOW)			
29	37	COARSE SAND & FINE GRAVEL			
37	38	GRAVEL			
38	39	LIMESTONE			
39	48	SLATE (GRAY)			

7 CONTRACTOR'S OR LANDOWNER'S CERTIFICATION: This water well was (1) constructed, (2) reconstructed, or (3) plugged under my jurisdiction and was completed on (mo/day/year) **4/18/89** and this record is true to the best of my knowledge and belief. Kansas Water Well Contractor's License No. **240** This Water Well Record was completed on (mo/day/yr) **5/2/89**

under the business name of **F.E. YOUNG DRILLING CO** by (signature) **Red Young**

INSTRUCTIONS: Use typewriter or ball point pen. PLEASE PRESS FIRMLY and PRINT clearly. Please fill in blanks, underline or circle the correct answers. Send top three copies to Kansas Department of Health and Environment, Bureau of Water Protection, Topeka, Kansas 66620-7320, Telephone: 913-862-9360. Send one to WATER WELL OWNER and retain one for your records.

OFFICE USE ONLY

T

R

EW

SEC.

1/4

1/4

1/4