


1 LOCATION OF WATER WELL: Fraction SW 1/4 NE 1/4 SW 1/4 Section Number 12 Township Number T 11 S Range Number R 24 EW  
 County: Wyandotte

Distance and direction from nearest town or city street address of well if located within city?  
4800 Kaw Drive MW-7

2 WATER WELL OWNER: Forest View Landfill Board of Agriculture, Division of Water Resources  
 RR#, St. Address, Box #: 4800 Kaw Drive Application Number:  
 City, State, ZIP Code: K.C. Kansas 66111

3 LOCATE WELL'S LOCATION WITH AN "X" IN SECTION BOX:

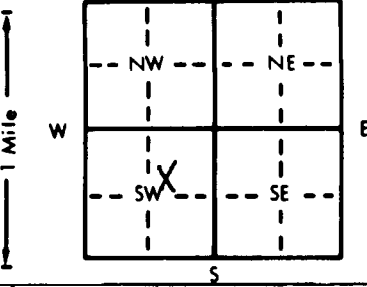

4 DEPTH OF COMPLETED WELL: 98.0 ft. ELEVATION: 9.10  
 Depth(s) Groundwater Encountered 1. .... ft. 2. .... ft. 3. .... ft.  
 WELL'S STATIC WATER LEVEL .... ft. below land surface measured on mo/day/yr  
 Pump test data: Well water was .... ft. after .... hours pumping .... gpm  
 Est. Yield .... gpm Well water was .... ft. after .... hours pumping .... gpm  
 Bore Hole Diameter: 6 in. to 94.5 ft., and .... in. to .... ft.

WELL WATER TO BE USED AS:  
 5 Public water supply 8 Air conditioning 11 Injection well  
 1 Domestic 3 Feedlot 6 Oil field water supply 9 Dewatering 12 Other (Specify below)  
 2 Irrigation 4 Industrial 7 Lawn and garden only 10 Observation well Monitoring  
 Was a chemical/bacteriological sample submitted to Department? Yes ..... No  If yes, mo/day/yr sample was submitted  
 Water Well Disinfected? Yes ..... No

5 TYPE OF BLANK CASING USED:  
 1 Steel 3 RMP (SR) 5 Wrought iron 8 Concrete tile CASING JOINTS: Glued ..... Clamped .....  
2 PVC 4 ABS 6 Asbestos-Cement 9 Other (specify below) Welded .....  
 7 Fiberglass Threaded

Blank casing diameter: 2 in. to .... ft., Dia. .... in. to .... ft., Dia. .... in. to .... ft.  
 Casing height above land surface: 30 in., weight .... lbs./ft. Wall thickness or gauge No. sch 40

TYPE OF SCREEN OR PERFORATION MATERIAL:  
 1 Steel 3 Stainless steel 5 Fiberglass 8 RMP (SR) 10 Asbestos-cement  
 2 Brass 4 Galvanized steel 6 Concrete tile 9 ABS 11 Other (specify) .....  
 12 None used (open hole)

SCREEN OR PERFORATION OPENINGS ARE:  
 1 Continuous slot 3 Mill slot 5 Gauzed wrapped 8 Saw cut 11 None (open hole)  
 2 Louvered shutter 4 Key punched 6 Wire wrapped 9 Drilled holes  
 7 Torch cut 10 Other (specify) .....

SCREEN-PERFORATED INTERVALS: From 91.0 ft. to 81.0 ft., From .... ft. to .... ft.  
 From .... ft. to .... ft., From .... ft. to .... ft.  
 GRAVEL PACK INTERVALS: From 94.5 ft. to 79.0 ft., From .... ft. to .... ft.  
 From .... ft. to .... ft., From .... ft. to .... ft.

6 GROUT MATERIAL: 1 Neat cement 2 Cement grout 3 Bentonite 4 Other .....  
 Grout Intervals: From 79.0 ft. to 75.0 ft., From 75.0 ft. to 0.0 ft., From .... ft. to .... ft.

What is the nearest source of possible contamination:  
 1 Septic tank 4 Lateral lines 7 Pit privy 10 Livestock pens 14 Abandoned water well  
 2 Sewer lines 5 Cess pool 8 Sewage lagoon 11 Fuel storage 15 Oil well/Gas well  
 3 Watertight sewer lines 6 Seepage pit 9 Feedyard 12 Fertilizer storage 16 Other (specify below)  
 Direction from well? North east 13 Insecticide storage Landfill  
 How many feet? 1500

FROM	TO	LITHOLOGIC LOG	FROM	TO	LITHOLOGIC LOG
0	2.5	Brown silty clay			
2.5	18.5	yellow brown weathered f.s.			
18.5	20.5	olive brown weathered shale			
20.5	23.5	gray white crystalline L.S.			
23.5	59.0	gray shale			
59.0	64.5	L.S.			
64.5	67.0	shale			
67.0	69.0	L.S.			
69.0	81.5	shale			
81.5	83.0	interbedded L.S + shale			
83.0	91.5	L.S.			
91.5	94.5	shale			

7 CONTRACTOR'S OR LANDOWNER'S CERTIFICATION: This water well was (1) constructed (2) reconstructed, or (3) plugged under my jurisdiction and was completed on (mo/day/year) 9-28-89 and this record is true to the best of my knowledge and belief. Kansas  
 Water Well Contractor's License No. 438 This Water Well Record was completed on (mo/day/yr) 10-27-89  
 under the business name of Kansas City Testing Lab by (signature) Richard C Leade

INSTRUCTIONS: Use typewriter or ball point pen. PLEASE PRESS FIRMLY and PRINT clearly. Please fill in blanks, underline or circle the correct answers. Send top three copies to Kansas Department of Health and Environment, Bureau of Water Protection, Topeka, Kansas 66620-7320, Telephone: 913-862-9360. Send one to WATER WELL OWNER and retain one for your records.