


1 LOCATION OF WATER WELL:	Fraction	Section Number	Township Number	Range Number
County: Wyandotte	SW 1/4 SE 1/4 NE NW NE 1/4	12	T 11 S	R 24 E/W

Distance and direction from nearest town or city	street address of well if located within city?
well # TB 13	4800 Kaw Drive, Kansas City, KS

2	WATER WELL OWNER:	Forest View Recycling & Disposal Facility	
	RR#, St. Address, Box # :	4800 Kaw Drive	Board of Agriculture, Division of Water Resources
	City, State, ZIP Code :	Kansas City, KS 66102	Application Number:

3 LOCATE WELL'S LOCATION WITH AN "X" IN SECTION BOX: 4 DEPTH OF COMPLETED WELL: 93 ft. ELEVATION: 82
Depth(s) Groundwater Encountered 1. 82 ft. 2. ft. 3. ft.

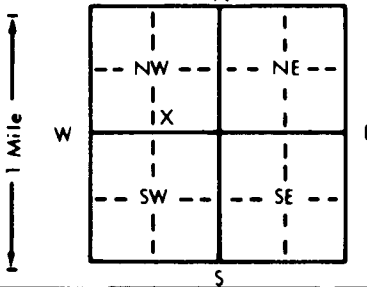

4 DEPTH OF COMPLETED WELL 93 ft. ELEVATION:
 Depth(s) Groundwater Encountered 1. 82 ft. 2. ft. 3. ft.
 WELL'S STATIC WATER LEVEL 82 ft. below land surface measured on mo/day/yr 5-11-91
 Pump test data: Well water was ft. after hours pumping not pumped
 Est. Yield gpm: Well water was ft. after hours pumping gpm
 Bore Hole Diameter 8 in. to 36 ft., and 6" in. to 93 ft.
 WELL WATER TO BE USED AS: 5 Public water supply 8 Air conditioning 11 Injection well
 1 Domestic 3 Feedlot 6 Oil field water supply 9 Dewatering 12 Other (Specify below)
 2 Irrigation 4 Industrial 7 Lawn and garden only 10 Monitoring well piezometer
 Was a chemical/bacteriological sample submitted to Department? Yes.....No.....X.....; If yes, mo/day/yr sample was submitted
 Water Well Disinfected? Yes No

5	TYPE OF BLANK CASING USED:			5 Wrought iron	8 Concrete tile	CASING JOINTS: Glued Clamped Welded <u>Threaded</u>
	1 Steel	3 RMP (SR)	6 Asbestos-Cement	9 Other (specify below)		
	<u>2</u> PVC	4 ABS	7 Fiberglass			

Blank casing diameter 2 in. to 83 ft. Dia. in. to ft. Dia. in. to ft.
Casing height above land surface 22" in. weight lbs./ft. Wall thickness or gauge No. schedule 40

TYPE OF SCREEN OR PERFORATION MATERIAL:

1 Steel	3 Stainless steel	5 Fiberglass	7 PVC	10 Asbestos-cement
2 Brass	4 Galvanized steel	6 Concrete tile	8 RMP (SR)	11 Other (specify)
			9 ABS	12 None used (open hole)

SCREEN OR PERFORATION OPENINGS ARE:

1 Continuous slot	3 Mill slot	5 Gauzed wrapped	8 Saw cut	11 None (open hole)
2 Louvered shutter	4 Key punched	6 Wire wrapped	9 Drilled holes	
		7 Torch cut	10 Other (specify)	

SCREEN-PERFORATED INTERVALS:	From	83	ft. to	93	ft., From		ft. to		ft.
	From		ft. to		ft., From		ft. to		ft.
GRAVEL PACK INTERVALS:	From		ft. to		ft., From		ft. to		ft.
	From	79	ft. to	93	ft., From		ft. to		ft.

6 GROUT MATERIAL: 1 Neat cement 2 Cement grout 3 Bentonite 4 Other

Grout Intervals: From 0 ① ft. to 2 ft. From 2 ③ ft. to 79 ft. From ft. to ft.

What is the nearest source of possible contamination:

1 Septic tank	4 Lateral lines	7 Pit privy	10 Livestock pens	14 Abandoned water well
2 Sewer lines	5 Cess pool	8 Sewage lagoon	11 Fuel storage	15 Oil well/Gas well
3 Watertight sewer lines	6 Seepage pit	9 Feedyard	12 Fertilizer storage	16 Other (specify below)
			13 Insecticide storage	landfill

Direction from well? Northwest How many feet? 1200

[illegible]

7 CONTRACTOR'S OR LANDOWNER'S CERTIFICATION: This water well was (1) constructed, (2) reconstructed, or (3) plugged under my jurisdiction and was completed on (mo/day/year) 5-11-91 and this record is true to the best of my knowledge and belief. Kansas Water Well Contractor's License No. 542 This Water Well Record was completed on (mo/day/yr) 6-24-91 under the business name of Luisier Drilling, Inc. by (signature) [Signature]