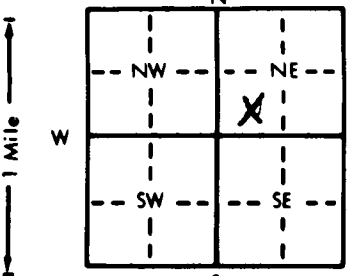


1 LOCATION OF WATER WELL:		Fraction	Section Number	Township Number	Range Number
County: WYANDOTTE		1/4 SW 1/4 NE 1/4	12	T 11 S	R 24 EN
Distance and direction from nearest town or city street address of well if located within city? 20' SOUTH OF MUNCIE DRIVE GP-1c					
2 WATER WELL OWNER: WASTE MANAGEMENT					
RR#, St. Address, Box # : 4800 KAW DR PO BOX 11116			Board of Agriculture, Division of Water Resources		
City, State, ZIP Code : KANSAS CITY KS 66111			Application Number:		
3 LOCATE WELL'S LOCATION WITH AN "X" IN SECTION BOX:		4 DEPTH OF COMPLETED WELL: 70.5 ft. ELEVATION:			
		Depth(s) Groundwater Encountered 1. ft. 2. ft. 3. ft.			
		WELL'S STATIC WATER LEVEL 60.5 ft. below land surface measured on mo/day/yr			
		Pump test data: Well water was ft. after hours pumping gpm			
		Est. Yield gpm: Well water was ft. after hours pumping gpm			
		Bore Hole Diameter 6 in. to 70.5 ft., and in. to ft.			
		WELL WATER TO BE USED AS:			
		5 Public water supply 8 Air conditioning 11 Injection well			
		1 Domestic 3 Feedlot 6 Oil field water supply 9 Dewatering 12 Other (Specify below)			
		2 Irrigation 4 Industrial 7 Lawn and garden only 10 Observation well VAPOR TEST			
		Was a chemical/bacteriological sample submitted to Department? Yes No X If yes, mo/day/yr sample was submitted			
		Water Well Disinfected? Yes No			
5 TYPE OF BLANK CASING USED:					
1 Steel 3 RMP (SR) 5 Wrought iron 8 Concrete tile CASING JOINTS: Glued Clamped					
2 PVC 4 ABS 6 Asbestos-Cement 9 Other (specify below) Welded					
Blank casing diameter 1 in. to 60.5 ft., Dia. in. to ft., Dia. in. to ft.					
Casing height above land surface 26 in., weight lbs./ft. Wall thickness or gauge No. SCH-40					
TYPE OF SCREEN OR PERFORATION MATERIAL:					
1 Steel 3 Stainless steel 5 Fiberglass 8 RMP (SR) 10 Asbestos-cement					
2 Brass 4 Galvanized steel 6 Concrete tile 9 ABS 11 Other (specify)					
SCREEN OR PERFORATION OPENINGS ARE:					
5 Gauzed wrapped 8 Saw cut 11 None (open hole)					
1 Continuous slot 3 Mill slot 6 Wire wrapped 9 Drilled holes					
2 Louvered shutter 4 Key punched 7 Torch cut 10 Other (specify)					
SCREEN-PERFORATED INTERVALS: From 70.5 ft. to 60.5 ft., From ft. to ft.					
GRAVEL PACK INTERVALS: From 70.5 ft. to 56.5 ft., From ft. to ft.					
6 GROUT MATERIAL: 1 Neat cement 2 Cement grout 3 Bentonite 4 Other					
Grout Intervals: From 56.5 ft. to 0 ft., From ft. to ft., From ft. to ft.					
What is the nearest source of possible contamination:					
1 Septic tank 4 Lateral lines 7 Pit privy 10 Livestock pens 14 Abandoned water well					
2 Sewer lines 5 Cess pool 8 Sewage lagoon 11 Fuel storage 15 Oil well/Gas well					
3 Watertight sewer lines 6 Seepage pit 9 Feedyard 12 Fertilizer storage 16 Other (specify below)					
Direction from well? LANDFILL 100' SOUTH					
How many feet?					
LITHOLOGIC LOG					
FROM	TO	LITHOLOGIC LOG	FROM	TO	LITHOLOGIC LOG
0		LIGHT BROWN SILTY CLAY MOIST			
	5.0	MEDIUM PLASTIC			
5.0		LOESS-VARYING SHADES OF BROWN			
		SILTY CLAY WITH TRACE OF FINE			
		SAND, SLIGHTLY MOIST STIFF			
	70.5	PLASTIC			
	70.5	LIMESTONE			
7 CONTRACTOR'S OR LANDOWNER'S CERTIFICATION: This water well was (1) constructed, (2) reconstructed, or (3) plugged under my jurisdiction and was completed on (mo/day/year) 2/21/92 and this record is true to the best of my knowledge and belief. Kansas Water Well Contractor's License No. 438-A This Water Well Record was completed on (mo/day/yr) 2/26/92 under the business name of KANSAS CITY TESTING LABORATORY by (signature) Richard C. Leeds					
INSTRUCTIONS: Use typewriter or ball point pen. PLEASE PRESS FIRMLY and PRINT clearly. Please fill in blanks, underline or circle the correct answers. Send top three copies to Kansas Department of Health and Environment, Bureau of Water Protection, Topeka, Kansas 66620-7320, Telephone: 913-862-9360. Send one to WATER WELL OWNER and retain one for your records.					