WATER WELL RECORD Form WWC-5 KSA 82a-1212

1 LOCATION OF WATER WELL: County: WYANDOTTE | Fraction: ¼ SW ¼ NE ¼ | Section Number: 12 | Township Number: T 11 S | Range Number: R 24 (E)W

Distance and direction from nearest town or city street address of well if located within city?
20' SOUTH OF MUNCIE DRIVE GP-1b

2 WATER WELL OWNER:
RR#, St. Address, Box # : WASTE MANAGEMENT
City, State, ZIP Code : 4800 KAW DR PO BOX 11116 KANSAS CITY KS 66111

Board of Agriculture, Division of Water Resources Application Number:

3 LOCATE WELL'S LOCATION WITH AN "X" IN SECTION BOX:

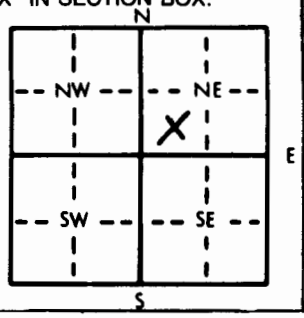

4 DEPTH OF COMPLETED WELL 40.0 ft. ELEVATION:
Depth(s) Groundwater Encountered 1. DRY ft. 2. ft. 3. ft.
WELL'S STATIC WATER LEVEL 999 ft. below land surface measured on mo/day/yr
Pump test data: Well water was ft. after hours pumping gpm
Est. Yield gpm: Well water was ft. after hours pumping gpm
Bore Hole Diameter 6 in. to 40.0 ft., and in. to ft.
WELL WATER TO BE USED AS: 1 Domestic 2 Irrigation 3 Feedlot 4 Industrial 5 Public water supply 6 Oil field water supply 7 Lawn and garden only 8 Air conditioning 9 Dewatering 10 Observation well 11 Injection well (12) Other (Specify below) VAPOR TEST
Was a chemical/bacteriological sample submitted to Department? Yes No X; If yes, mo/day/yr sample was submitted
Water Well Disinfected? Yes No

5 TYPE OF BLANK CASING USED: 1 Steel (2) PVC 3 RMP (SR) 4 ABS 5 Wrought iron 6 Asbestos-Cement 7 Fiberglass 8 Concrete tile 9 Other (specify below)
CASING JOINTS: (Glued) Clamped Welded (Threaded)
Blank casing diameter 1 in. to 30.0 ft., Dia in. to ft., Dia in. to ft.
Casing height above land surface 26 in., weight lbs./ft. Wall thickness or gauge No. SCH-40
TYPE OF SCREEN OR PERFORATION MATERIAL: 1 Steel 2 Brass 3 Stainless steel 4 Galvanized steel 5 Fiberglass 6 Concrete tile (7) PVC 8 RMP (SR) 9 ABS 10 Asbestos-cement 11 Other (specify) 12 None used (open hole)
SCREEN OR PERFORATION OPENINGS ARE: 1 Continuous slot 2 Louvered shutter 3 Mill slot 4 Key punched 5 Gauzed wrapped 6 Wire wrapped 7 Torch cut (8) Saw cut (9) Drilled holes 10 Other (specify) 11 None (open hole)
SCREEN-PERFORATED INTERVALS: From 40.0 ft. to 30.0 ft., From ft. to ft.
From ft. to ft., From ft. to ft.
GRAVEL PACK INTERVALS: From 40.0 ft. to 26.0 ft., From ft. to ft.
From ft. to ft., From ft. to ft.

6 GROUT MATERIAL: (1) Neat cement 2 Cement grout 3 Bentonite 4 Other
Grout Intervals: From ft. to 0 ft., From ft. to ft., From ft. to ft.
What is the nearest source of possible contamination: 1 Septic tank 2 Sewer lines 3 Watertight sewer lines 4 Lateral lines 5 Cess pool 6 Seepage pit 7 Pit privy 8 Sewage lagoon 9 Feedyard 10 Livestock pens 11 Fuel storage 12 Fertilizer storage 13 Insecticide storage 14 Abandoned water well 15 Oil well/Gas well (16) Other (specify below) LANDFILL
Direction from well? How many feet? 100' SOUTH

FROM	TO	LITHOLOGIC LOG	FROM	TO	LITHOLOGIC LOG
0		LOESS-BROWN SILTY CLAYS WITH			
		FINE SAND - MOIST - MED PLASTIC			
	40.0				

7 CONTRACTOR'S OR LANDOWNER'S CERTIFICATION: This water well was (1) constructed, (2) reconstructed, or (3) plugged under my jurisdiction and was completed on (mo/day/year) 2/21/92 and this record is true to the best of my knowledge and belief. Kansas Water Well Contractor's License No. 438-A This Water Well Record was completed on (mo/day/yr) 2/26/92 under the business name of KANSAS CITY TESTING LABORATORY by (signature) Richard C. Leede

INSTRUCTIONS: Use typewriter or ball point pen. *PLEASE PRESS FIRMLY* and *PRINT* clearly. Please fill in blanks, underline or circle the correct answers. Send top three copies to Kansas Department of Health and Environment, Bureau of Water Protection, Topeka, Kansas 66620-7320, Telephone: 913-862-9360. Send one to WATER WELL OWNER and retain one for your records.

OFFICE USE ONLY T R E/W SEC. ¼ ¼ ¼