


1 LOCATION OF WATER WELL: County: Wyandotte Fraction: SW 1/4 SE 1/4 NW 1/4 Section Number: 12 Township Number: T 11 S Range Number: R 24 E/W

Distance and direction from nearest town or city street address of well if located within city?
4800 Kaw Drive Kansas City KS 66111

2 WATER WELL OWNER: Waste Management - Forest View
 RR#, St. Address, Box #: 4800 Kaw Drive, PO Box 11116
 City, State, ZIP Code: Kansas City, KS 66111
 Board of Agriculture, Division of Water Resources
 Application Number:

3 LOCATE WELL'S LOCATION WITH AN "X" IN SECTION BOX:
 4 DEPTH OF COMPLETED WELL: 152 ft. ELEVATION:

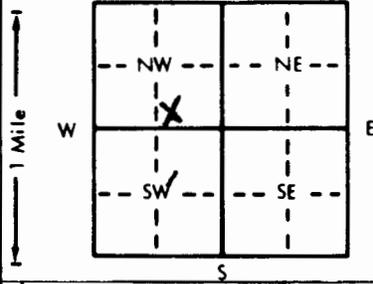

Depth(s) Groundwater Encountered 1. ft. 2. ft. 3. ft.
 WELL'S STATIC WATER LEVEL ft. below land surface measured on mo/day/yr
 Pump test data: Well water was ft. after hours pumping gpm
 Est. Yield gpm: Well water was ft. after hours pumping gpm
 Bore Hole Diameter: 8 3/4 in. to 67 ft. and 6 in. to 152 ft.
 WELL WATER TO BE USED AS:
 5 Public water supply 8 Air conditioning 11 Injection well
 1 Domestic 3 Feedlot 6 Oil field water supply 9 Dewatering 12 Other (Specify below)
 2 Irrigation 4 Industrial 7 Lawn and garden only 10 Monitoring well MW-289
 Was a chemical/bacteriological sample submitted to Department? Yes.....No...X...; If yes, mo/day/yr sample was submitted
 Water Well Disinfected? Yes No

5 TYPE OF BLANK CASING USED:
 1 Steel 2 PVC 3 RMP (SR) 4 ABS 5 Wrought iron 6 Asbestos-Cement 7 Fiberglass 8 Concrete tile 9 Other (specify below) 10 Asbestos-cement
 Blank casing diameter: 2 in. to 142 ft. Dia. in. to ft. Dia. in. to ft. Dia. in. to ft.
 Casing height above land surface: 30 in. weight lbs./ft. Wall thickness or gauge No. Sch 40

TYPE OF SCREEN OR PERFORATION MATERIAL:
 1 Steel 2 Brass 3 Stainless steel 4 Galvanized steel 5 Fiberglass 6 Concrete tile 7 PVC 7 PVC 8 RMP (SR) 9 ABS 10 Asbestos-cement 11 Other (specify) 12 None used (open hole)

SCREEN OR PERFORATION OPENINGS ARE:
1 Continuous slot 2 Louvered shutter 3 Mill slot 4 Key punched 5 Gauzed wrapped 6 Wire wrapped 7 Torch cut 8 Saw cut 9 Drilled holes 10 Other (specify) 11 None (open hole)

SCREEN-PERFORATED INTERVALS: From 142 ft. to 152 ft. From ft. to ft. From ft. to ft.
 GRAVEL PACK INTERVALS: From 137 ft. to 152 ft. From ft. to ft. From ft. to ft.

6 GROUT MATERIAL: 1 Neat cement 2 Cement grout 3 Bentonite 4 Other
 Grout Intervals: From 0 ft. to 142 ft. From 3 ft. to 137 ft. From ft. to ft.

What is the nearest source of possible contamination:
 1 Septic tank 2 Sewer lines 3 Watertight sewer lines 4 Lateral lines 5 Cess pool 6 Seepage pit 7 Pit privy 8 Sewage lagoon 9 Feedyard 10 Livestock pens 11 Fuel storage 12 Fertilizer storage 13 Insecticide storage 14 Abandoned water well 15 Oil well/Gas well
6 Other (specify below) Sanitary Landfill

Direction from well? South How many feet? 100

FROM	TO	LITHOLOGIC LOG	FROM	TO	PLUGGING INTERVALS
0	67	Yel. br. Silty Clay (Loess)			
67	80	Lt. Gray Limestone			
80	82	Dk. Gray Shale (Quindaro)			
82	86	Grey Limestone (Frisbie)			
86	119	Grey Shale (Lane)			
119	126	Lt. brown Limestone (Raytown)			
126	127	Black Shale (Munice Creek)			
127	129	Brown Limestone (Paola)			
129	142	Olive Gray Shale (Chanute)			
142	151	Brown Limestone (Drum)			
151	152	Grey Black Shale (Quivera)			

7 CONTRACTOR'S OR LANDOWNER'S CERTIFICATION: This water well was (1) constructed (2) reconstructed, or (3) plugged under my jurisdiction and was completed on (mo/day/year) 6-3-92 and this record is true to the best of my knowledge and belief. Kansas Water Well Contractor's License No. 542 This Water Well Record was completed on (mo/day/yr) 6/20/92 under the business name of Luisier Drilling Inc by (signature) Ken Meyers