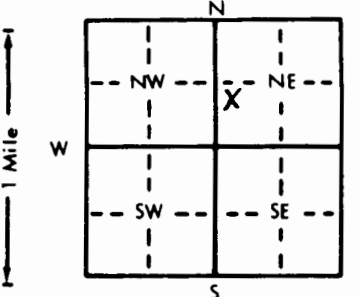


1 LOCATION OF WATER WELL: County: Wyandotte Fraction: NW 1/4 SW 1/4 NE 1/4 Section Number: 12 Township Number: T 11 S Range Number: R 24 E EW

Distance and direction from nearest town or city street address of well if located within city?
4800 Kaw Drive Kansas City KS 66111

2 WATER WELL OWNER: Waste Management - Forest View Landfill
 RR#, St. Address, Box #: 4800 Kaw Drive PO Box 11116 Board of Agriculture, Division of Water Resources
 City, State, ZIP Code: Kansas City, KS 66111 Application Number:

3 LOCATE WELL'S LOCATION WITH AN "X" IN SECTION BOX:

 4 DEPTH OF COMPLETED WELL: 156 ft. ELEVATION:
 Depth(s) Groundwater Encountered 1. ft. 2. ft. 3. ft.
 WELL'S STATIC WATER LEVEL ft. below land surface measured on mo/day/yr
 Pump test data: Well water was ft. after hours pumping gpm
 Est. Yield gpm: Well water was ft. after hours pumping gpm
 Bore Hole Diameter: 10 in. to 87 ft., and 6 in. to 156 ft.
 WELL WATER TO BE USED AS: 5 Public water supply 8 Air conditioning 11 Injection well
 1 Domestic 3 Feedlot 6 Oil field water supply 9 Dewatering 12 Other (Specify below)
 2 Irrigation 4 Industrial 7 Lawn and garden only 10 Monitoring well MW-121
 Was a chemical/bacteriological sample submitted to Department? Yes.....No X.....; If yes, mo/day/yr sample was submitted
 Water Well Disinfected? Yes No Yes

5 TYPE OF BLANK CASING USED:
 1 Steel 3 RMP (SR) 5 Wrought iron 8 Concrete tile CASING JOINTS: Glued Clamped
2 PVC 4 ABS 6 Asbestos-Cement 9 Other (specify below) Welded
 7 Fiberglass Threaded O-ring, Teflon
 Blank casing diameter 2 in. to 146 ft., Dia in. to ft., Dia in. to ft.
 Casing height above land surface: 30 in., weight lbs./ft. Wall thickness or gauge No. Sch 40
 TYPE OF SCREEN OR PERFORATION MATERIAL:
 1 Steel 3 Stainless steel 5 Fiberglass 1 PVC 10 Asbestos-cement
 2 Brass 4 Galvanized steel 6 Concrete tile 8 RMP (SR) 11 Other (specify)
 9 ABS 12 None used (open hole)
 SCREEN OR PERFORATION OPENINGS ARE:
 1 Continuous slot 3 Mill slot 5 Gauzed wrapped 8 Saw cut 11 None (open hole)
 2 Louvered shutter 4 Key punched 6 Wire wrapped 9 Drilled holes
 7 Torch cut 10 Other (specify)
 SCREEN-PERFORATED INTERVALS: From 146 ft. to 156 ft., From ft. to ft.
 From ft. to ft., From ft. to ft.
 GRAVEL PACK INTERVALS: From 141 ft. to 156 ft., From ft. to ft.
 From ft. to ft., From ft. to ft.

6 GROUT MATERIAL: 1 Neat cement 2 Cement grout 3 Bentonite 4 Other
 Grout intervals: From 0 ft. to 141 ft., From 2 ft. to 141 ft., From ft. to ft.
 What is the nearest source of possible contamination:
 1 Septic tank 4 Lateral lines 7 Pit privy 10 Livestock pens 14 Abandoned water well
 2 Sewer lines 5 Cess pool 8 Sewage lagoon 11 Fuel storage 15 Oil well/Gas well
 3 Watertight sewer lines 6 Seepage pit 9 Feedyard 12 Fertilizer storage 16 Other (specify below)
Sanitary Landfill
 13 Insecticide storage
 Direction from well? SW How many feet? 106

FROM	TO	LITHOLOGIC LOG	FROM	TO	PLUGGING INTERVALS
0	87	Yel. Br. Silty Clay (Loess)			
87	102	Grey f.g. Limestone (Argentine)			
102	107	Dk. Grey Shale (Quindaro)			
107	112	Grey Limestone (Frisbie)			
112	145	Grey Shale (Lane)			
145	152	Grey Limestone (Raytown)			
152	153	Black Shale (Muncie Creek)			
153	155	Lt. Br. Limestone (Paola)			
155	156	Grey Shale (Chanute)			

7 CONTRACTOR'S OR LANDOWNER'S CERTIFICATION: This water well was 1 constructed (2) reconstructed, or (3) plugged under my jurisdiction and was completed on (mo/day/year) 5-13-92 and this record is true to the best of my knowledge and belief. Kansas Water Well Contractor's License No. 542 This Water Well Record was completed on (mo/day/yr) 6/20/92 under the business name of Luisier Drilling Inc by (signature) Ken Meyer

INSTRUCTIONS: Use typewriter or ball point pen. PLEASE PRESS FIRMLY and PRINT clearly. Please fill in blanks, underline or circle the correct answers. Send top three copies to Kansas Department of Health and Environment, Bureau of Water, Topeka, Kansas 66620-0001. Telephone: 913-296-5545. Send one to WATER WELL OWNER and retain one for your records.