

1 LOCATION OF WATER WELL: County: <u>Wyandotte</u>	Fraction <u>NE 1/4 NW 1/4 SE 1/4</u>	Section Number <u>12</u>	Township Number T <u>11</u> S	Range Number R <u>24</u> E
---	---	-----------------------------	----------------------------------	-------------------------------

Distance and direction from nearest town or city street address of well if located within city?

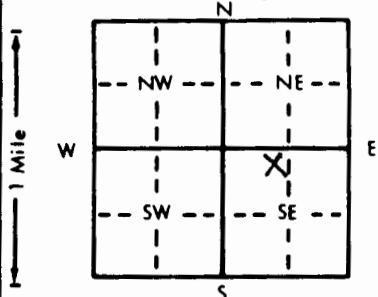
4800 Kaw Drive Kansas City, KS2 WATER WELL OWNER: Waste Management - Forest View LandfillRR#, St. Address, Box #: 4800 Kaw Drive, P.O. Box 11116

Board of Agriculture, Division of Water Resources

City, State, ZIP Code: Kansas City, KS 66111

Application Number:

3 LOCATE WELL'S LOCATION WITH AN "X" IN SECTION BOX:

4 DEPTH OF COMPLETED WELL: 116.5 ft. ELEVATION:

Depth(s) Groundwater Encountered 1. .... ft. 2. .... ft. 3. .... ft.

WELL'S STATIC WATER LEVEL .... ft. below land surface measured on mo/day/yr

Pump test data: Well water was .... ft. after .... hours pumping .... gpm

Est. Yield .... gpm: Well water was .... ft. after .... hours pumping .... gpm

Bore Hole Diameter: 10 in. to 30 in. and 6 in. to 11.7 in.

WELL WATER TO BE USED AS: 5 Public water supply 8 Air conditioning 11 Injection well

1 Domestic 3 Feedlot 6 Oil field water supply 9 Dewatering 12 Other (Specify below)

2 Irrigation 4 Industrial 7 Lawn and garden only 10 Monitoring well MW-223Was a chemical/bacteriological sample submitted to Department? Yes ..... No X ..... If yes, mo/day/yr sample was submittedWater Well Disinfected? Yes No

5 TYPE OF BLANK CASING USED:

1 Steel

3 RMP (SR)

5 Wrought iron

8 Concrete tile

CASING JOINTS: Glued ..... Clamped .....

2 PVC

4 ABS

6 Asbestos-Cement

9 Other (specify below)

Welded .....

7 Fiberglass

Threaded Orange, TeflonBlank casing diameter .... 2 in. to 106.5 ft. Dia .... in. to .... ft. Dia .... in. to .... ft.Casing height above land surface .... 30 in. weight .... lbs./ft. Wall thickness or gauge No. Sch. 40

TYPE OF SCREEN OR PERFORATION MATERIAL:

1 Steel

3 Stainless steel

5 Fiberglass

7 PVC

10 Asbestos-cement

2 Brass

4 Galvanized steel

6 Concrete tile

8 RMP (SR)

11 Other (specify) .....

9 ABS

12 None used (open hole)

SCREEN OR PERFORATION OPENINGS ARE:

1 Continuous slot

3 Mill slot

5 Gauzed wrapped

8 Saw cut

11 None (open hole)

2 Louvered shutter

4 Key punched

6 Wire wrapped

9 Drilled holes

SCREEN-PERFORATED INTERVALS: From .... 106.5 ft. to .... 116.5 ft. From .... ft. to .... ft.

From .... ft. to .... ft. From .... ft. to .... ft.

GRAVEL PACK INTERVALS: From .... 101.5 ft. to .... 116.5 ft. From .... ft. to .... ft.

From .... ft. to .... ft. From .... ft. to .... ft.

6 GROUT MATERIAL: 1 Neat cement 2 Cement grout 3 Bentonite 4 OtherGrout intervals: From 10 ft. to 2 ft. From 3 ft. to 101.5 ft. From .... ft. to .... ft.

What is the nearest source of possible contamination:

1 Septic tank

4 Lateral lines

7 Pit privy

10 Livestock pens

14 Abandoned water well

2 Sewer lines

5 Cess pool

8 Sewage lagoon

11 Fuel storage

15 Oil well/Gas well

3 Watertight sewer lines 6 Seepage pit

9 Feedyard

12 Fertilizer storage

16 Other (specify below)

13 Insecticide storage

Sanitary Landfill

Direction from well?

How many feet?

FROM	TO	LITHOLOGIC LOG	FROM	TO	PLUGGING INTERVALS
0	29	Yel. Br. Silty Clay (Loess)			
29	39	Grey Limestone (Argentine)			
39	42	Grey Shale			
42	47	Lt. Grey Limestone			
47	82	Grey Shale (Lane)			
82	91	Grey Limestone (Raytown)			
91	93	Black Shale (Muncie Creek)			
93	95	Grey Limestone (Paola)			
95	107	Grey Shale (Chanute)			
107	116	Brown Limestone (Drum)			
116	117	Black/Grey Shale			

7 CONTRACTOR'S OR LANDOWNER'S CERTIFICATION: This water well was (1) constructed (2) reconstructed, or (3) plugged under my jurisdiction and was completed on (mo/day/year) 5-16-92 and this record is true to the best of my knowledge and belief. KansasWater Well Contractor's License No. 542 This Water Well Record was completed on (mo/day/yr) 6/20/92under the business name of Luisier Drilling Inc by (signature) Ken Meyer