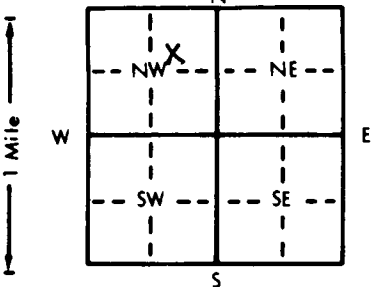


|   |      |   |                |                                                   |                    |
|---|------|---|----------------|---------------------------------------------------|--------------------|
| <b>1 LOCATION OF WATER WELL:</b>   |      | Fraction                                                                                           | Section Number | Township Number                                   | Range Number       |
| County: <b>WYANDOTTE</b>   |      | <b>SW 1/4 NE 1/4 NW 1/4</b>                                                                        | <b>13</b>      | <b>T 11 S</b>                                     | <b>R 24 EW</b>     |
| Distance and direction from nearest town or city street address of well if located within city?<br><b>5200 SPEAKER RD KANSAS CITY KANSAS</b>   |      |   |                |                                                   |                    |
| <b>2 WATER WELL OWNER: HARCROS CHEMICALS INC</b>   |      |   |                |                                                   |                    |
| RR#, St. Address, Box # : <b>5200 SPEAKER RD</b>   |      |   |                | Board of Agriculture, Division of Water Resources |                    |
| City, State, ZIP Code : <b>KANSAS CITY KANSAS 66106</b>   |      |   |                | Application Number:                               |                    |
| <b>3 LOCATE WELL'S LOCATION WITH AN "X" IN SECTION BOX:</b>   |      | <b>4 DEPTH OF COMPLETED WELL: 78</b> ft. ELEVATION:                                                |                |                                                   |                    |
| <div style="text-align: center;"></div>   |      | Depth(s) Groundwater Encountered 1. . . . . ft. 2. . . . . ft. 3. . . . . ft.                      |                |                                                   |                    |
|   |      | WELL'S STATIC WATER LEVEL <b>66</b> ft. below land surface measured on mo/day/yr                   |                |                                                   |                    |
|   |      | Pump test data: Well water was . . . . . ft. after . . . . . hours pumping . . . . . gpm           |                |                                                   |                    |
|   |      | Est. Yield . . . . . gpm: Well water was . . . . . ft. after . . . . . hours pumping . . . . . gpm |                |                                                   |                    |
|   |      | Bore Hole Diameter . . . . . in. to . . . . . ft., and . . . . . in. to . . . . . ft.              |                |                                                   |                    |
| WELL WATER TO BE USED AS:   |      | 5 Public water supply 8 Air conditioning 11 Injection well                                         |                |                                                   |                    |
| 1 Domestic 3 Feedlot 6 Oil field water supply 9 Dewatering 12 Other (Specify below)   |      |   |                |                                                   |                    |
| 2 Irrigation 4 Industrial 7 Lawn and garden only <b>10 Monitoring well</b>   |      |   |                |                                                   |                    |
| Was a chemical/bacteriological sample submitted to Department? Yes . . . . . No <b>X</b> . . . . .; If yes, mo/day/yr sample was submitted   |      |   |                |                                                   |                    |
| Water Well Disinfected? Yes . . . . . No   |      |   |                |                                                   |                    |
| <b>5 TYPE OF BLANK CASING USED:</b>   |      |   |                |                                                   |                    |
| 1 Steel 3 RMP (SR) 6 Asbestos-Cement 9 Other (specify below)   |      | CASING JOINTS: Glued . . . . . Clamped . . . . .                                                   |                |                                                   |                    |
| <b>2 PVC</b> 4 ABS 7 Fiberglass   |      | Welded . . . . .                                                                                   |                |                                                   |                    |
|   |      | Threaded <b>X</b>                                                                                  |                |                                                   |                    |
| Blank casing diameter . . . . . <b>1.0</b> in. to <b>66.9</b> ft., Dia . . . . . in. to . . . . . ft., Dia . . . . . in. to . . . . . ft.   |      |   |                |                                                   |                    |
| Casing height above land surface . . . . . in., weight . . . . . lbs./ft. Wall thickness or gauge No. . . . .   |      |   |                |                                                   |                    |
| TYPE OF SCREEN OR PERFORATION MATERIAL:   |      |   |                |                                                   |                    |
| 1 Steel 3 Stainless steel 5 Fiberglass 8 RMP (SR)   |      | 10 Asbestos-cement                                                                                 |                |                                                   |                    |
| 2 Brass 4 Galvanized steel 6 Concrete tile 9 ABS   |      | 11 Other (specify) . . . . .                                                                       |                |                                                   |                    |
|   |      | 12 None used (open hole)                                                                           |                |                                                   |                    |
| SCREEN OR PERFORATION OPENINGS ARE:   |      |   |                |                                                   |                    |
| 1 Continuous slot 3 Mill slot 5 Gauzed wrapped 8 Saw cut 11 None (open hole)   |      |   |                |                                                   |                    |
| 2 Louvered shutter 4 Key punched 6 Wire wrapped 9 Drilled holes   |      |   |                |                                                   |                    |
|   |      | 7 Torch cut 10 Other (specify) . . . . .                                                           |                |                                                   |                    |
| SCREEN-PERFORATED INTERVALS: From <b>66.9</b> ft. to <b>76.7</b> ft., From . . . . . ft. to . . . . . ft.   |      |   |                |                                                   |                    |
| From . . . . . ft. to . . . . . ft., From . . . . . ft. to . . . . . ft.   |      |   |                |                                                   |                    |
| GRAVEL PACK INTERVALS: From <b>64.5</b> ft. to <b>78.0</b> ft., From . . . . . ft. to . . . . . ft.   |      |   |                |                                                   |                    |
| From . . . . . ft. to . . . . . ft., From . . . . . ft. to . . . . . ft.   |      |   |                |                                                   |                    |
| <b>6 GROUT MATERIAL:</b> 1 Neat cement 2 Cement grout 3 Bentonite <b>6 Other CEMENT - BENTONITE</b>   |      |   |                |                                                   |                    |
| Grout Intervals: From <b>3.0</b> ft. to <b>64.5</b> ft., From . . . . . ft. to . . . . . ft., From . . . . . ft. to . . . . . ft.   |      |   |                |                                                   |                    |
| What is the nearest source of possible contamination:   |      |   |                |                                                   |                    |
| 1 Septic tank 4 Lateral lines 7 Pit privy 10 Livestock pens 14 Abandoned water well   |      |   |                |                                                   |                    |
| 2 Sewer lines 5 Cess pool 8 Sewage lagoon 11 Fuel storage 15 Oil well/Gas well   |      |   |                |                                                   |                    |
| 3 Watertight sewer lines 6 Seepage pit 9 Feedyard 12 Fertilizer storage <b>13 Insecticide storage</b> <b>16 Other (specify below) CHEMICAL MFG SITE</b>   |      |   |                |                                                   |                    |
| Direction from well? How many feet?   |      |   |                |                                                   |                    |
| FROM   | TO   | LITHOLOGIC LOG                                                                                     | FROM           | TO                                                | PLUGGING INTERVALS |
| 0   | 1    | ASPHALT                                                                                            |                |                                                   |                    |
| 1   | 1.5  | FILL                                                                                               |                |                                                   |                    |
| 1.5   | 38   | SILTY SAND                                                                                         |                |                                                   |                    |
| 38   | 77.7 | SAND                                                                                               |                |                                                   |                    |
| 77.7   | 78   | SHALE                                                                                              |                |                                                   |                    |
| <b>7 CONTRACTOR'S OR LANDOWNER'S CERTIFICATION:</b> This water well was <b>(1) constructed</b> , (2) reconstructed, or (3) plugged under my jurisdiction and was completed on (mo/day/year) <b>12/11/92</b> and this record is true to the best of my knowledge and belief. Kansas Water Well Contractor's License No. <b>102</b> This Water Well Record was completed on (mo/day/yr) <b>9-28-93</b> under the business name of <b>LAYNE WESTERN</b> by (signature) <b>[Signature]</b> |      |   |                |                                                   |                    |
| INSTRUCTIONS: Use typewriter or ball point pen. PLEASE PRESS FIRMLY and PRINT clearly. Please fill in blanks, underline or circle the correct answers. Send top three copies to Kansas Department of Health and Environment, Bureau of Water, Topeka, Kansas 66620-0001. Telephone: 913-296-5545. Send one to WATER WELL OWNER and retain one for your records.   |      |   |                |                                                   |                    |