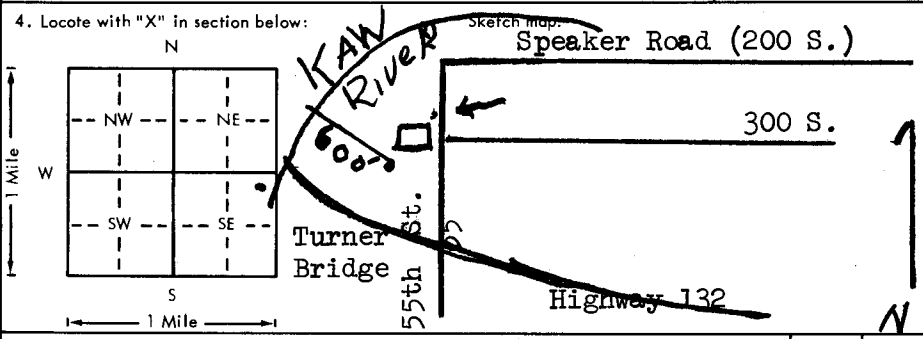


USE TYPEWRITER OR BALL
POINT PEN-PRESS FIRMLY,
PRINT CLEARLY.

WATER WELL RECORD
KSA 82a-1201-1215

Kansas Department of Health and
Environment-Division of Environment
(Water well Contractors)
Topeka, Kansas 66620

1. Location of well:		County Wyandotte	Fraction NE 1/4 NE 1/4 SE 1/4	Section number 14	Township number T 11S	Range number S R 24E E/W
2. Distance and direction from nearest town or city: Street address of well location if in city: 300 S. 55th Street				3. Owner of well: Strongheart Products Co. City, state, zip code: 300 S. 55th Street Kansas City, Kansas 66110		
4. Locote with "X" in section below: 				6. Bore hole dia. 30 in. Completion date 3-27-81 Well depth 68 ft.		
5. Type and color of material				7. <input checked="" type="checkbox"/> Cable tool <input checked="" type="checkbox"/> Rotary <input type="checkbox"/> Driven <input type="checkbox"/> Dug <input type="checkbox"/> Hollow rod <input type="checkbox"/> Jetted <input type="checkbox"/> Bored <input type="checkbox"/> Reverse rotary		
Top Soil				8. Use: <input type="checkbox"/> Domestic <input type="checkbox"/> Public supply <input checked="" type="checkbox"/> Industry <input type="checkbox"/> Irrigation <input type="checkbox"/> Air conditioning <input type="checkbox"/> Stock <input type="checkbox"/> Lawn <input type="checkbox"/> Oil field water <input type="checkbox"/> Other		
Fine Silty Sand				9. Casing: Material steel Height: Above or below Threaded <input type="checkbox"/> Welded <input checked="" type="checkbox"/> Surface 5 in. RMP 20 PVC 48 Weight 42 lbs./ft. Dia. 20 in. to 48 ft. depth Wall Thickness: inches or Dia. 20 in. to 48 ft. depth gage No. 250		
Fine Sand (Water)				10. Screen: Manufacturer's name Houston Well Screen Co. Type 304 SS Bar Weld Dia. 20 in. Slot/gauze .050 Length 20 ft. Set between 48 ft. and 68 ft. ft. and 68 ft. Gravel pack? yes Size range of material 1/8 to 3/8		
Sand, Fine to Course				11. Static water level: 38 ft. below land surface Date 2-9-81		
Sand, Fine with Clay Seams				12. Pumping level below land surfaces: 47 1/2 ft. after 1 hrs. pumping 600 g.p.m. 47 1/2 ft. after 6 hrs. pumping 600 g.p.m. Estimated maximum yield 600 g.p.m.		
Sand & Gravel with Clay Seams				13. Water sample submitted: mo./day/yr. <input type="checkbox"/> Yes <input checked="" type="checkbox"/> No Date 2-9-81		
Sand Gravel, & Boulders				14. Well head completion: Well Pit <input checked="" type="checkbox"/> Pitless adapter 12 inches above grade		
Total depth 68				15. Well grouted? yes With: <input checked="" type="checkbox"/> Neat cement <input type="checkbox"/> Bentonite <input type="checkbox"/> Concrete Depth: From 5 ft. to 30 ft.		
(Use a second sheet if needed)				16. Nearest source of possible contamination: ft. 600 Direction NW Type Kaw River Well disinfected upon completion? <input checked="" type="checkbox"/> Yes <input type="checkbox"/> No		
18. Elevation: 762 Topography: <input type="checkbox"/> Hill <input type="checkbox"/> Slope <input type="checkbox"/> Upland <input type="checkbox"/> Valley				17. Pump: <input type="checkbox"/> Not installed Manufacturer's name Worthington Model number 10 H75 HP Volts 240 Length of drop pipe 600 ft. capacity 600 g.p.m. Type: <input type="checkbox"/> Submersible <input checked="" type="checkbox"/> Turbine <input type="checkbox"/> Jet <input type="checkbox"/> Reciprocating <input type="checkbox"/> Centrifugal <input type="checkbox"/> Other		
19. Remarks:				20. Water well contractor's certification: This well was drilled under my jurisdiction and this report is true to the best of my knowledge and belief. Bill Doolittle 392 Business name R I Buckner License No. 4121 Address Ray Signed Ray Date 4/2/81 Authorized representative		

Forward the white, blue and pink copies to the Department of Health and Environment

Form WWC-5