


WATER WELL RECORD Form WWC-5 KSA 82a-1212

1 LOCATION OF WATER WELL: County: Wyandotte Fraction SW SE SE 1/4 Section Number 11 Township Number T 11 S Range Number R 24 E/W

Distance and direction from nearest town or city street address of well if located within city? 575 feet SE of the intersection of 57th Street and K-32.

2 WATER WELL OWNER: Phillips Pipe Line Co. RR#, St. Address, Box #: 370 Adams Bldg. City, State, ZIP Code: Bartlesville, OK 74004 Board of Agriculture, Division of Water Resources Application Number:

3 LOCATE WELL'S LOCATION WITH AN "X" IN SECTION BOX: 4 DEPTH OF COMPLETED WELL: 44.19 ft. ELEVATION: 755.78 (ground)

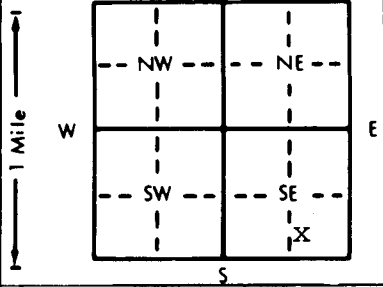

Depth(s) Groundwater Encountered 1. 34.5 ft. 2. ft. 3. ft. WELL'S STATIC WATER LEVEL 33.51 ft. below land surface measured on mo/day/yr 12/2/94 Pump test data: Well water was ft. after hours pumping gpm Est. Yield gpm Well water was ft. after hours pumping gpm Bore Hole Diameter 8 in. to 45.0 ft., and in. to ft. WELL WATER TO BE USED AS: 5 Public water supply 8 Air conditioning 11 Injection well 1 Domestic 3 Feedlot 6 Oil field water supply 9 Dewatering 12 Other (Specify below) 2 Irrigation 4 Industrial 7 Lawn and garden only 10 Monitoring well Was a chemical/bacteriological sample submitted to Department? Yes No X If yes, mo/day/yr sample was submitted Water Well Disinfected? Yes No X

5 TYPE OF BLANK CASING USED: 1 Steel 3 RMP (SR) 5 Wrought iron 8 Concrete tile CASING JOINTS: Glued Clamped 2 PVC 4 ABS 6 Asbestos-Cement 9 Other (specify below) Welded 7 Fiberglass Threaded X

Blank casing diameter 2 in. to 26.1 ft., Dia in. to ft., Dia in. to ft. Casing height above land surface 27.2 in., weight lbs./ft. Wall thickness or gauge No. SCH 40

TYPE OF SCREEN OR PERFORATION MATERIAL: 1 Steel 3 Stainless steel 5 Fiberglass 8 RMP (SR) 10 Asbestos-cement 2 Brass 4 Galvanized steel 6 Concrete tile 9 ABS 12 None used (open hole)

SCREEN OR PERFORATION OPENINGS ARE: 1 Continuous slot 3 Mill slot 5 Gauzed wrapped 8 Saw cut 11 None (open hole) 2 Louvered shutter 4 Key punched 6 Wire wrapped 9 Drilled holes 7 Torch cut 10 Other (specify)

SCREEN-PERFORATED INTERVALS: From 26.1 ft. to 40.53 ft., From ft. to ft. GRAVEL PACK INTERVALS: From 25.2 ft. to 44.19 ft., From ft. to ft.

6 GROUT MATERIAL: 1 Neat cement 2 Cement grout 3 Bentonite 4 Other Grout Intervals: From 0.45 ft. to 23.1 ft., From ft. to ft., From ft. to ft.

What is the nearest source of possible contamination: 1 Septic tank 4 Lateral lines 7 Pit privy 10 Livestock pens 14 Abandoned water well 2 Sewer lines 5 Cess pool 8 Sewage lagoon 11 Fuel storage 15 Oil well/Gas well 3 Watertight sewer lines 6 Seepage pit 9 Feedyard 12 Fertilizer storage 16 Other (specify below) 13 Insecticide storage Petroleum product line

Direction from well? How many feet?

Table with columns: FROM, TO, LITHOLOGIC LOG, FROM, TO, PLUGGING INTERVALS. Rows show depth intervals and lithology: 0-9.5 sandy silt, 9.5-14.5 silty clay, 14.5-19.5 silty sand, 19.5-20.6 sand, 20.6-24.5 silty sand, 24.5-44.5 sand, 44.5-45.0 gravelly sand.

7 CONTRACTOR'S OR LANDOWNER'S CERTIFICATION: This water well was 1 constructed, (2) reconstructed, or (3) plugged under my jurisdiction and was completed on (mo/day/year) 11/30/94 and this record is true to the best of my knowledge and belief. Kansas Water Well Contractor's License No. 5160 This Water Well Record was completed on (mo/day/yr) 12/27/94 under the business name of GEO SYSTEMS ENGINEERING INC by (signature) Rich Bridges