WATER WELL RECORD Form WWC-5 KSA 82a-1212

1 LOCATION OF WATER WELL: County: Wyandotte | Fraction: ¼ NE ¼ SE ¼ | Section Number: 20 | Township Number: T 11 S | Range Number: R 25 (E)/W

Distance and direction from nearest town or city street address of well if located within city?
South of Argentine Blvd., East of 26th Street, Kansas City, Kansas

2 WATER WELL OWNER: The Atchison, Topeka, Santa Fe Railway Company MW 95-5
RR#, St. Address, Box # : 920 SE Quincy
City, State, ZIP Code : Topeka, KS 66612
Board of Agriculture, Division of Water Resources
Application Number:

3 LOCATE WELL'S LOCATION WITH AN "X" IN SECTION BOX:

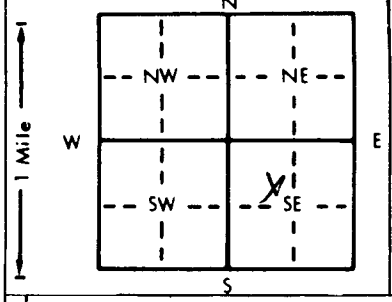

4 DEPTH OF COMPLETED WELL 34.2 ft. ELEVATION: 749.59
Depth(s) Groundwater Encountered 1. 19.3 ft. 2. ft. 3. ft.
WELL'S STATIC WATER LEVEL 19.3 ft. below land surface measured on mo/day/yr 4-10-95
Pump test data: Well water was ft. after hours pumping gpm
Est. Yield gpm: Well water was ft. after hours pumping gpm
Bore Hole Diameter in. to ft., and in. to ft.
WELL WATER TO BE USED AS: 5 Public water supply 8 Air conditioning 11 Injection well
1 Domestic 3 Feedlot 6 Oil field water supply 9 Dewatering 12 Other (Specify below)
2 Irrigation 4 Industrial 7 Lawn and garden only (10) Monitoring well
Was a chemical/bacteriological sample submitted to Department? Yes No X; If yes, mo/day/yr sample was submitted
Water Well Disinfected? Yes No X

5 TYPE OF BLANK CASING USED: 5 Wrought iron 8 Concrete tile CASING JOINTS: Glued Clamped
1 Steel 3 RMP (SR) 6 Asbestos-Cement 9 Other (specify below) Welded
(2) PVC 4 ABS 7 Fiberglass Threaded X
Blank casing diameter 2 in. to 16 ft., Dia in. to ft., Dia in. to ft.
Casing height above land surface 0 in., weight 0.10 lbs./ft. Wall thickness or gauge No. Sch 40
TYPE OF SCREEN OR PERFORATION MATERIAL: (7) PVC 10 Asbestos-cement
1 Steel 3 Stainless steel 5 Fiberglass 8 RMP (SR) 11 Other (specify)
2 Brass 4 Galvanized steel 6 Concrete tile 9 ABS 12 None used (open hole)
SCREEN OR PERFORATION OPENINGS ARE: 5 Gauzed wrapped 8 Saw cut 11 None (open hole)
1 Continuous slot (3) Mill slot 6 Wire wrapped 9 Drilled holes
2 Louvered shutter 4 Key punched 7 Torch cut 10 Other (specify)
SCREEN-PERFORATED INTERVALS: From 16 ft. to 31 ft., From ft. to ft.
From 14 ft. to 34.2 ft., From ft. to ft.
GRAVEL PACK INTERVALS: From 14 ft. to 34.2 ft., From ft. to ft.
From ft. to ft., From ft. to ft.

6 GROUT MATERIAL: 1 Neat cement 2 Cement grout 3 Bentonite 4 Other
Grout Intervals: From 12 ft. to C ft., From ft. to ft., From ft. to ft.
What is the nearest source of possible contamination:
1 Septic tank 4 Lateral lines 7 Pit privy 10 Livestock pens 14 Abandoned water well
2 Sewer lines 5 Cess pool 8 Sewage lagoon (11) Fuel storage 15 Oil well/Gas well
3 Watertight sewer lines 6 Seepage pit 9 Feedyard 12 Fertilizer storage 16 Other (specify below)
13 Insecticide storage
Direction from well? How many feet? 1150

FROM	TO	LITHOLOGIC LOG
		See attached
0	1	gravel/fill
1	13.5	Sand
13.5	14	none
14	15.5	Sand
15.5	16.5	clay
16.5	19	Sand
19	19.2	none
19.2	21.5	Sand
21.5	24.2	none
24.2	25	Sand
25	27.5	clay
27.5	28.5	Sand

FROM	TO	PLUGGING INTERVALS
28.5	29	none
29	34.2	Sand

7 CONTRACTOR'S OR LANDOWNER'S CERTIFICATION: This water well was (1) constructed, (2) reconstructed, or (3) plugged under my jurisdiction and was completed on (mo/day/year) 4-10-95 and this record is true to the best of my knowledge and belief. Kansas Water Well Contractor's License No. 102 This Water Well Record was completed on (mo/day/yr) 7-24-95
under the business name of Layne Inc by (signature)

INSTRUCTIONS: Use typewriter or ball point pen. PLEASE PRESS FIRMLY and PRINT clearly. Please fill in blanks, underline or circle the correct answers. Send top three copies to Kansas Department of Health and Environment, Bureau of Water, Topeka, Kansas 66620-0001. Telephone: 913-296-5545. Send one to WATER WELL OWNER and retain one for your records.

OFFICE USE ONLY T R E/W SEC. ¼ ¼ ¼