WATER WELL RECORD Form WWC-5 KSA 82a-1212

1 LOCATION OF WATER WELL: County: Wyandotte	Fraction: ¼ NE ¼ SE ¼	Section Number: 20	Township Number: T 11 S	Range Number: R 25 (E/W)

Distance and direction from nearest town or city street address of well if located within city?
South of Argentine Blvd, East of 26th Street, Kansas City, Kansas

2 WATER WELL OWNER: The Atchison, Topeka, Santa Fe Railway — MW 95-13
RR#, St. Address, Box # : 920 SE Quincy — Board of Agriculture, Division of Water Resources
City, State, ZIP Code : Topeka, KS 66612 — Application Number:

3 LOCATE WELL'S LOCATION WITH AN "X" IN SECTION BOX:

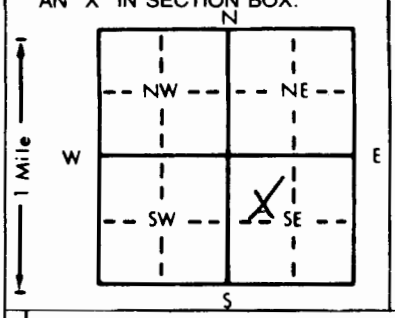

4 DEPTH OF COMPLETED WELL 38 ft. ELEVATION: 751.33
Depth(s) Groundwater Encountered 1. 29 ft. 2. ft. 3. ft.
WELL'S STATIC WATER LEVEL 29.9 ft. below land surface measured on mo/day/yr 4-26-95
Pump test data: Well water was ft. after hours pumping gpm
Est. Yield gpm: Well water was ft. after hours pumping gpm
Bore Hole Diameter in. to ft., and in. to ft.
WELL WATER TO BE USED AS: 5 Public water supply 8 Air conditioning 11 Injection well
1 Domestic 3 Feedlot 6 Oil field water supply 9 Dewatering 12 Other (Specify below)
2 Irrigation 4 Industrial 7 Lawn and garden only (10) Monitoring well
Was a chemical/bacteriological sample submitted to Department? Yes No X; If yes, mo/day/yr sample was submitted
Water Well Disinfected? Yes No X

5 TYPE OF BLANK CASING USED: 5 Wrought iron 8 Concrete tile CASING JOINTS: Glued Clamped
(1) Steel 3 RMP (SR) 6 Asbestos-Cement 9 Other (specify below) Welded
(2) PVC 4 ABS 7 Fiberglass Threaded X
Blank casing diameter 2 in. to 24 ft., Dia in. to ft., Dia in. to ft.
Casing height above land surface 0 in., weight 0.70 lbs./ft. Wall thickness or gauge No. Sch 40
TYPE OF SCREEN OR PERFORATION MATERIAL: (7) PVC 10 Asbestos-cement
1 Steel 3 Stainless steel 5 Fiberglass 8 RMP (SR) 11 Other (specify)
2 Brass 4 Galvanized steel 6 Concrete tile 9 ABS 12 None used (open hole)
SCREEN OR PERFORATION OPENINGS ARE: 5 Gauzed wrapped 8 Saw cut 11 None (open hole)
1 Continuous slot (3) Mill slot 6 Wire wrapped 9 Drilled holes
2 Louvered shutter 4 Key punched 7 Torch cut 10 Other (specify)
SCREEN-PERFORATED INTERVALS: From 24 ft. to 38 ft., From ft. to ft.
From 22 ft. to 38 ft., From ft. to ft.
GRAVEL PACK INTERVALS: From 22 ft. to 38 ft., From ft. to ft.
From ft. to ft., From ft. to ft.

6 GROUT MATERIAL: 1 Neat cement 2 Cement grout 3 Bentonite 4 Other
Grout Intervals: From 19.5 ft. to 0 ft., From ft. to ft., From ft. to ft.
What is the nearest source of possible contamination: 10 Livestock pens 14 Abandoned water well
1 Septic tank 4 Lateral lines 7 Pit privy (11) Fuel storage 15 Oil well/Gas well
2 Sewer lines 5 Cess pool 8 Sewage lagoon 12 Fertilizer storage 16 Other (specify below)
3 Watertight sewer lines 6 Seepage pit 9 Feedyard 13 Insecticide storage
Direction from well? How many feet? 950

FROM	TO	LITHOLOGIC LOG	FROM	TO	PLUGGING INTERVALS
		see attached	29	34	sand
			34	38	none
0	1	gravel fill			
1	13.6	sand			
13.6	14	none			
14	18	sand			
18	19	none			
19	22.8	sand			
22.8	24	none			
24	26.5	sand			
26.5	29	none			

7 CONTRACTOR'S OR LANDOWNER'S CERTIFICATION: This water well was (1) constructed, (2) reconstructed, or (3) plugged under my jurisdiction and was completed on (mo/day/year) 4-26-95 and this record is true to the best of my knowledge and belief. Kansas Water Well Contractor's License No. 102 This Water Well Record was completed on (mo/day/yr) 7-24-95
under the business name of Layne clm by (signature)

INSTRUCTIONS: Use typewriter or ball point pen. *PLEASE PRESS FIRMLY* and *PRINT* clearly. Please fill in blanks, underline or circle the correct answers. Send top three copies to Kansas Department of Health and Environment, Bureau of Water, Topeka, Kansas 66620-0001. Telephone: 913-296-5545. Send one to WATER WELL OWNER and retain one for your records.

OFFICE USE ONLY — T — R — E/W — SEC. — ¼ — ¼ — ¼