


1 LOCATION OF WATER WELL:	Fraction	Section Number	Township Number	Range Number
County: Wyandotte	1/4 1/4 SE 1/4	3	T 11 S	R 25 EW

Distance and direction from nearest town or city street address of well if located within city?
1421 3rd St. Kansas City, KS (See attached drawing) MW-4

2 WATER WELL OWNER: Western Resources, Inc.
RR#, St. Address, Box # : 200 S.W. 6th St., 2nd Floor
City, State, ZIP Code : Toneka, KS 66603

3 LOCATE WELL'S LOCATION WITH AN "X" IN SECTION BOX: 4 DEPTH OF COMPLETED WELL... 39.0 ft. ELEVATION: .

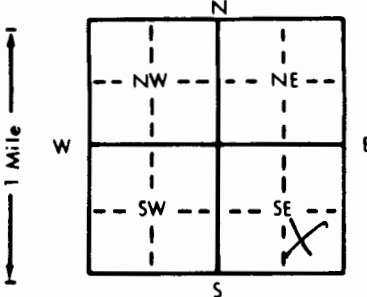

4 DEPTH OF COMPLETED WELL... 39.0 ft. ELEVATION:
 Depth(s) Groundwater Encountered 1. ft. 2. ft. 3. ft.
 WELL'S STATIC WATER LEVEL ft. below land surface measured on mo/day/yr
 Pump test data: Well water was ft. after hours pumping gpm
 Est. Yield gpm: Well water was ft. after hours pumping gpm
 Bore Hole Diameter... 8 in. to 39.6 ft., and... in. to ft.
 WELL WATER TO BE USED AS: 5 Public water supply 8 Air conditioning 11 Injection well
 1 Domestic 3 Feedlot 6 Oil field water supply 9 Dewatering 12 Other (Specify below)
 2 Irrigation 4 Industrial 7 Lawn and garden only 10 Monitoring well
 Was a chemical/bacteriological sample submitted to Department? Yes.....No.....
 If yes, mo/day/yr sample was submitted
 Water Well Disinfected? Yes.....No.....

5	TYPE OF BLANK CASING USED:		5 Wrought iron	8 Concrete tile	CASING JOINTS: Glued Clamped Welded Threaded ✓
	1 Steel	3 RMP (SR)	6 Asbestos-Cement	9 Other (specify below)	
	2 PVC	4 ABS	7 Fiberglass		

Blank casing diameter in. to ft., Dia in. to ft., Dia in. to ft.
Casing height above land surface 0 in., weight Sch. 40 lbs./ft. Wall thickness or gauge No. Flush-mount

TYPE OF SCREEN OR PERFORATION MATERIAL:			☒ PVC	10 Asbestos-cement	Cover
1 Steel	3 Stainless steel	5 Fiberglass	8 RMP (SR)	11 Other (specify)	
2 Brass	4 Galvanized steel	6 Concrete tile	9 ABS	12 None used (open hole)	

SCREEN OR PERFORATION OPENINGS ARE:

1 Continuous slot	③ Mill slot	5 Gauzed wrapped	8 Saw cut	11 None (open hole)
2 Louvered shutter	4 Key punched	6 Wire wrapped	9 Drilled holes	
		7 Torch cut	10 Other (specify)	

SCREEN-PERFORATED INTERVALS:	From	24.5	ft. to	34.0	ft. From	ft. to	ft.
	From		ft. to		ft. From	ft. to	ft.
GRAVEL PACK INTERVALS:	From	22.1	ft. to	39.6	ft. From	ft. to	ft.
	From		ft. to		ft. From	ft. to	ft.

GROUT MATERIAL: 1 Neat cement 2 Cement grout 3 Bentonite 4 Other
Grout Intervals: From 1.5 ft. to 22.1 ft. From ft. to Concrete ft. From 0 ft. to 1.5 ft.

What is the nearest source of possible contamination:

1 Septic tank	4 Lateral lines	7 Pit privy	10 Livestock pens	14 Abandoned water well
2 Sewer lines	5 Cess pool	8 Sewage lagoon	11 Fuel storage	15 Oil well/Gas well
3 Watertight sewer lines	6 Seepage pit	9 Feedyard	12 Fertilizer storage	16 Other (specify below)
			13 Insecticide storage	

Direction from well?	
	How many feet?

[illegible]

7 CONTRACTOR'S OR LANDOWNER'S CERTIFICATION: This water well was (1) constructed, (2) reconstructed, or (3) plugged under my jurisdiction and was completed on (mo/day/year) 11/26/96 and this record is true to the best of my knowledge and belief. Kansas Water Well Contractor's License No. 510 This Water Well Record was completed on (mo/day/yr) 12/2/96 under the business name of MIKON Corporation by (signature) David O. Kram