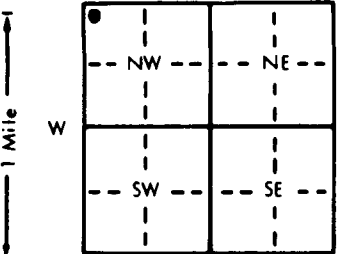


1 LOCATION OF WATER WELL: County: Wyandotte		Fraction NW 1/4 NW 1/4 NW 1/4		Section Number 22		Township Number T 11 S		Range Number R 25 EW	
Distance and direction from nearest town or city street address of well if located within city? 7th & Kansas Ave., Kansas City, KS.									
2 WATER WELL OWNER: Glo-Rae Investments RR#, St. Address, Box #: 605 W. 47th Suite City, State, ZIP Code: Kansas City, Mo. 64112 Board of Agriculture, Division of Water Resources Application Number:									
3 LOCATE WELL'S LOCATION WITH AN "X" IN SECTION BOX: 			4 DEPTH OF COMPLETED WELL: 26 1/2' ft. ELEVATION: Depth(s) Groundwater Encountered 1 21' ft. 2. ft. 3. ft. WELL'S STATIC WATER LEVEL 20.07 ft. below land surface measured on mo/day/yr 4-4-97 Pump test data: Well water was ft. after hours pumping gpm Est. Yield gpm: Well water was ft. after hours pumping gpm Bore Hole Diameter 8 1/2" in. to 26 1/2" ft., and in. to ft. WELL WATER TO BE USED AS: 5 Public water supply 8 Air conditioning 11 Injection well 1 Domestic 3 Feedlot 6 Oil field water supply 9 Dewatering 12 Other (Specify below) 2 Irrigation 4 Industrial 7 Lawn and garden only 10 Monitoring well Was a chemical/bacteriological sample submitted to Department? Yes No X; If yes, mo/day/yr sample was submitted Water Well Disinfected? Yes No X						
5 TYPE OF BLANK CASING USED: 1 Steel 3 RMP (SR) 5 Wrought iron 8 Concrete tile CASING JOINTS: Glued Clamped 2 PVC 4 ABS 6 Asbestos-Cement 9 Other (specify below) Welded Blank casing diameter 2.375 in. to 16 1/2" ft., Dia in. to ft., Dia in. to SDR 13 ft. Casing height above land surface 14 ft. in., weight lbs./ft. Wall thickness or gauge No. SCH 40 TYPE OF SCREEN OR PERFORATION MATERIAL: 1 Steel 3 Stainless steel 5 Fiberglass 8 RMP (SR) 10 Asbestos-cement 2 Brass 4 Galvanized steel 6 Concrete tile 9 ABS 11 Other (specify) 12 None used (open hole) SCREEN OR PERFORATION OPENINGS ARE: 1 Continuous slot 3 Mill slot 5 Gauzed wrapped 8 Saw cut 11 None (open hole) 2 Louvered shutter 4 Key punched 6 Wire wrapped 9 Drilled holes SCREEN-PERFORATED INTERVALS: From 26 1/2' ft. to 16 1/2' ft., From ft. to ft. GRAVEL PACK INTERVALS: From 26 1/2' ft. to 14' ft., From ft. to ft. 6 GROUT MATERIAL: 1 Neat cement 2 Cement grout 3 Bentonite 4 Other Grout Intervals: From 14' ft. to 4' ft., From 4' ft. to 0' ft., From ft. to ft. What is the nearest source of possible contamination: 1 Septic tank 4 Lateral lines 7 Pit privy 10 Livestock pens 14 Abandoned water well 2 Sewer lines 5 Cess pool 8 Sewage lagoon 11 Fuel storage Former 15 Oil well/Gas well 3 Watertight sewer lines 6 Seepage pit 9 Feedyard 12 Fertilizer storage 16 Other (specify below) 13 Insecticide storage Direction from well? Northwest How many feet? 60'									
FROM TO LITHOLOGIC LOG					FROM TO PLUGGING INTERVALS				
0 .75 Asphalt									
.75 1.50 Brn silty clay, moist, no odor.									
1.50 4 Dk gray-blk clayey silt, moist.									
4 7.50 Lt gray fine sand, dry, faint to no odor.									
7.50 15 Lt gray fine grained sand, dry, none to slight odor, well rounded & sorted.									
15 26.50 Gray fine-coarse sand, dry to moist, slight odor.									
7 CONTRACTOR'S OR LANDOWNER'S CERTIFICATION: This water well was (1) constructed, (2) reconstructed, or (3) plugged under my jurisdiction and was completed on (mo/day/year) 3-31-97 and this record is true to the best of my knowledge and belief. Kansas Water Well Contractor's License No. 539 This Water Well Record was completed on (mo/day/yr) 5-1-97 under the business name of JB Environmental Drilling by (signature) James Becker INSTRUCTIONS: Use typewriter or ball point pen. PLEASE PRESS FIRMLY and PRINT clearly. Please fill in blanks, underline or circle the correct answers. Send top three copies to Kansas Department of Health and Environment, Bureau of Water, Topeka, Kansas 66620-0001. Telephone: 913-296-5545. Send one to WATER WELL OWNER and retain one for your records.									