


1 LOCATION OF WATER WELL:		Fraction	Section Number		Township Number		Range Number	
County:	Wyandotte	NW ¼ SE ¼ NW ¼	10		T 11 S		R 25 E	

237 N. 7th, Kansas City, Kansas

Application Number:

submitted Water Well Disinfected? Yes No ☒

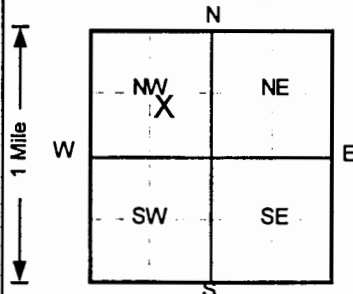

From ft to ft. From ft to ft

How many feet? 0

FROM	TO	LITHOLOGIC LOG	FROM	TO	PLUGGING INTERVALS
0	1	Gravel,			
1	7	Clay, Dark Brown			
7	10	Sand, Brown			
10	20	Clay, Brown/Gray			
					MW2 , Tag # 00192800 , Flushmount
					Project Name: Trafficway Service
					GeoCore # 505 , KDHE # U4 105 10941

7 CONTRACTOR'S OR LANDOWNER'S CERTIFICATION: This water well was (1) constructed, (2) reconstructed, or (3) plugged under my jurisdiction and was completed on (mo/day/year) 9/11/97 and this record is true to the best of my knowledge and belief.
Kansas Water Well Contractor's License No. 527 This Water Well Record was completed on (mo/day/yr) 10/8/97 under the business name of GeoCore Services, Inc. by (signature) Dale Dahl

INSTRUCTIONS: Use typewriter or ball point pen. **PLEASE PRESS FIRMLY** and **PRINT** clearly. Please fill in blanks, underline or circle the correct answers. Send top three copies to Kansas Department of Health and Environment, Bureau of Water, Topeka, Kansas 66620-0001. Telephone: 913-296-5545. Send one to **WATER WELL OWNER** and retain one for your records.