


1 LOCATION OF WATER WELL:	Fraction	Section Number	Township Number	Range Number
County: Wyandotte	NE ¼ NW ¼ NW ¼	21	T 11 S	R 25 E/W

Distance and direction from nearest town or city street address of well if located within city?
1517 Kansas Avenue, Kansas City, Kansas

2] WATER WELL OWNER: Armourdale Muffler Shop		Board of Agriculture, Division of Water Resources Application Number:
RR#, St. Address, Box #	: 5350 Swartz Road	
City, State, ZIP Code	: Kansas City, Kansas 66106	

3	LOCATE WELL'S LOCATION WITH AN "X" IN SECTION BOX: N	4	DEPTH OF COMPLETED WELL	30	ft	ELEVATION	751.44	
			Depth(s) Groundwater Encountered	1	24.6	ft	2	ft

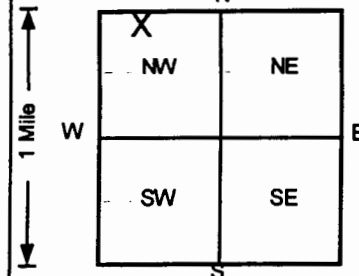

4) DEPTH OF COMPLETED WELL 30 ft ELEVATION: 751.44
 Depth(s) Groundwater Encountered 1. 24.6 ft 2. ft 3. ft
 WELL'S STATIC WATER LEVEL .. 24.62 ... ft below land surface measured on mo/day/yr 9/11/97
 Pump test data: Well water was NA ft after hours pumping gpm
 Est. Yield .. NA ... gpm: Well water was ft after hours pumping gpm
 Bore Hole Diameter 8. in. to 30 ft, and in. to ft
 WELL WATER TO BE USED AS: 5 Public water supply 8 Air conditioning 11 Injection well
 1 Domestic 3 Feedlot 6 Oil field water supply 9 Dewatering 12 Other (Specify below)
 2 Irrigation 4 Industrial 7 Lawn and garden only 10 Monitoring well
 Was a chemical/bacteriological sample submitted to Department? Yes.....No.....; If yes, mo/day/yr sample was submitted
 Water Well Disinfected? Yes No

5	TYPE OF BLANK CASING USED:		5 Wrought iron	8 Concrete tile	CASING JOINTS: Glued Clamped Welded Threaded
	1 Steel	3 RMP (SR)	6 Asbestos-Cement	9 Other (specify below)	
	2 PVC	4 ABS	7 Fiberglass		

Blank casing diameter 2 in. to 20 ft, Dia in. to ft, Dia in. to ft
Casing height above land surface -3.12 in. weight Sch 40 lbs./ft. Wall thickness or gauge No

TYPE OF SCREEN OR PERFORATION MATERIAL			7 PVC	10 Asbestos-cement
1 Steel	3 Stainless steel	5 Fiberglass	8 RMP (SR)	11 Other (specify)
2 Brass	4 Galvanized steel	6 Concrete tile	9 ABS	12 None used (open hole)

SCREEN OR PERFORATION OPENINGS ARE:

1 Continuous slot	3 Mill slot	5 Gauzed wrapped	8 Saw cut	11 None (open hole)
2 Lowered shutter	4 Key punched	6 Wire wrapped	9 Drilled holes	
		7 Torch cut	10 Other (specify)	

SCREEN-PERFORATED INTERVALS:	From	20	ft to	30	ft, From	ft to	ft
	From		ft to		ft, From	ft to	ft
GRAVEL PACK INTERVALS:	From	18	ft to	30	ft, From	ft to	ft
	From		ft to		ft, From	ft to	ft

6 GROUT MATERIAL: 1 Neat cement 2 Cement grout 3 Bentonite 4 Other

Grout Intervals: From 0 ft to 16 ft From 16 ft to 18 ft From ft to ft

What is the nearest source of possible contamination:

1 Septic tank	4 Lateral lines	7 Pit privy	10 Livestock pens	14 Abandoned water well
2 Sewer lines	5 Cess pool	8 Sewage lagoon	11 Fuel storage	15 Oil well/Gas well
3 Watertight sewer lines	6 Seepage pit	9 Feedyard	12 Fertilizer storage	16 Other (specify below)
			13 Insecticide storage	Former Tank Basins

Direction from well? Southwest

How many feet? 75

[illegible]

7] CONTRACTOR'S OR LANDOWNER'S CERTIFICATION: This water well was (1) constructed, (2) reconstructed, or (3) plugged under my jurisdiction and was completed on (mo/day/year) 9/3/97 and this record is true to the best of my knowledge and belief.
Kansas Water Well Contractor's License No. 527 This Water Well Record was completed on (mo/day/yr) 10/3/97
under the business name of GeoCore Services, Inc. by (signature) Dale Rohl

INSTRUCTIONS: Use typewriter or ball point pen. **PLEASE PRESS FIRMLY and PRINT** clearly. Please fill in blanks, underline or circle the correct answers. Send top three copies to Kansas Department of Health and Environment, Bureau of Water, Topeka, Kansas 66620-0001. Telephone: 913-296-5545. Send one to WATER WELL OWNER and retain one for your records.