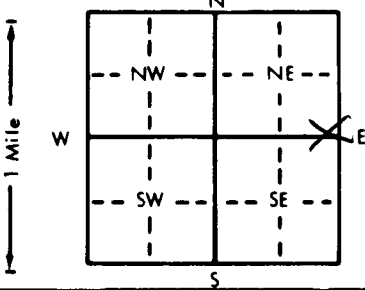


1 LOCATION OF WATER WELL: County: <u>Wyandotte</u> Fraction: <u>SE 1/4 SE 1/4 NE 1/4</u> Section Number: <u>10</u> Township Number: <u>T 11 S</u> Range Number: <u>R 25 EW</u>	
Distance and direction from nearest town or city street address of well if located within city? <u>347 N. James</u>	
2 WATER WELL OWNER: <u>Brotherhood Bank</u> RR#, St. Address, Box # : City, State, ZIP Code : <u>Kansas City KS</u> Application Number: <u>mw4</u> Board of Agriculture, Division of Water Resources	
3 LOCATE WELL'S LOCATION WITH AN "X" IN SECTION BOX: 	4 DEPTH OF COMPLETED WELL: <u>16</u> ft. ELEVATION: _____ Depth(s) Groundwater Encountered 1. _____ ft. 2. _____ ft. 3. _____ ft. WELL'S STATIC WATER LEVEL _____ ft. below land surface measured on mo/day/yr Pump test data: Well water was _____ ft. after _____ hours pumping _____ gpm Est. Yield _____ gpm: Well water was _____ ft. after _____ hours pumping _____ gpm Bore Hole Diameter _____ in. to _____ ft., and _____ in. to _____ ft. WELL WATER TO BE USED AS: 1 Domestic 3 Feedlot 6 Oil field water supply 8 Air conditioning 11 Injection well 2 Irrigation 4 Industrial 7 Lawn and garden only 9 Dewatering 12 Other (Specify below) Was a chemical/bacteriological sample submitted to Department? Yes _____ No <u>Yes</u> ; If yes, mo/day/yr sample was submitted _____ Water Well Disinfected? Yes _____ No <u>Yes</u>
5 TYPE OF BLANK CASING USED: 1 Steel 3 RMP (SR) 5 Wrought iron 8 Concrete tile CASING JOINTS: Glued _____ Clamped _____ 2 <u>PVC</u> 4 ABS 6 Asbestos-Cement 9 Other (specify below) _____ Welded _____ Blank casing diameter _____ in. to _____ ft., Dia _____ in. to _____ ft., Dia _____ in. to _____ ft. Casing height above land surface _____ in., weight _____ lbs./ft. Wall thickness or gauge No. _____ TYPE OF SCREEN OR PERFORATION MATERIAL: 1 Steel 3 Stainless steel 5 Fiberglass 7 <u>PVC</u> 10 Asbestos-cement 2 Brass 4 Galvanized steel 6 Concrete tile 8 RMP (SR) 11 Other (specify) _____ SCREEN OR PERFORATION OPENINGS ARE: 1 Continuous slot 3 Mill slot 5 Gauzed wrapped 8 Saw cut 11 None (open hole) 2 Louvered shutter 4 Key punched 7 Wire wrapped 9 Drilled holes SCREEN-PERFORATED INTERVALS: From _____ ft. to _____ ft., From _____ ft. to _____ ft. GRAVEL PACK INTERVALS: From _____ ft. to _____ ft., From _____ ft. to _____ ft.	
6 GROUT MATERIAL: 1 Neat cement 2 Cement grout 3 Bentonite 4 Other _____ Grout Intervals: From _____ ft. to _____ ft., From _____ ft. to _____ ft., From _____ ft. to _____ ft. What is the nearest source of possible contamination: 1 Septic tank 4 Lateral lines 7 Pit privy 10 Livestock pens 14 Abandoned water well 2 Sewer lines 5 Cess pool 8 Sewage lagoon 11 Fuel storage 15 Oil well/Gas well 3 Watertight sewer lines 6 Seepage pit 9 Feedyard 12 Fertilizer storage 16 Other (specify below) <u>LISTS</u> Direction from well? _____ How many feet? _____	
FROM TO LITHOLOGIC LOG FROM TO PLUGGING INTERVALS	
5 7	211
10 12	Silt, clay, trace f. sand, gray bn
15 17	Sand, m-c, bn
Flushmount lower by D. Taylor	
7 CONTRACTOR'S OR LANDOWNER'S CERTIFICATION: This water well was (1) constructed, (2) reconstructed, or (3) plugged under my jurisdiction and was completed on (mo/day/year) <u>5/11/98</u> and this record is true to the best of my knowledge and belief. Kansas Water Well Contractor's License No. <u>433</u> This Water Well Record was completed on (mo/day/yr) <u>5/10/98</u> under the business name of <u>TEST</u> by (signature) <u>Ron Ward by LL</u>	