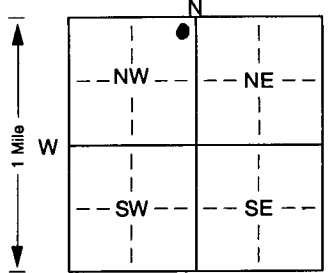


1 LOCATION OF WATER WELL: County: Wyandotte		Fraction NE $\frac{1}{4}$ NE $\frac{1}{4}$ NW $\frac{1}{4}$		Section Number 9		Township Number 11 T S		Range Number 25 R EAN	
Distance and direction from nearest town or city street address of well if located within city? Intown									
2 WATER WELL OWNER: Rain Tunnel Car Wash/Tom Schnabel									
RR#, St. Address, Box #: 1549 State Ave.						Board of Agriculture, Division of Water Resources			
City, State, ZIP Code: KC, KS.						Application Number:			
3 LOCATE WELL'S LOCATION WITH AN "X" IN SECTION BOX:		4 DEPTH OF COMPLETED WELL: 10' ft. ELEVATION:							
		Depth(s) Groundwater Encountered 1. ft. 2. ft. 3. ft.							
		WELL'S STATIC WATER LEVEL ft. below land surface measured on mo/day/yr							
		Pump test data: Well water was ft. after hours pumping gpm							
		Est. Yield gpm: Well water was ft. after hours pumping gpm							
		Bore Hole Diameter. in. to ft., and in. to ft.							
WELL WATER TO BE USED AS: 5 Public water supply 8 Air conditioning 11 Injection well									
1 Domestic 3 Feedlot 6 Oil field water supply 9 Dewatering 12 Other (Specify below)									
2 Irrigation 4 Industrial 7 Domestic (lawn & garden) 10 Monitoring well									
Was a chemical/bacteriological sample submitted to Department? Yes. No. ; If yes, mo/day/yr sample was submitted									
Water Well Disinfected? Yes No									
5 TYPE OF BLANK CASING USED: 5 Wrought iron 8 Concrete tile CASING JOINTS: Glued. Clamped.									
1 Steel 3 RMP (SR) 6 Asbestos-Cement 9 Other (specify below) Welded.									
2 PVC 4 ABS 7 Fiberglass Threaded.									
Blank casing diameter in. to ft., Dia in. to ft., Dia in. to ft.									
Casing height above land surface. in., weight lbs./ft. Wall thickness or gauge No.									
TYPE OF SCREEN OR PERFORATION MATERIAL: 7 PVC 10 Asbestos-cement									
1 Steel 3 Stainless steel 5 Fiberglass 8 RMP (SR) 11 Other (specify)									
2 Brass 4 Galvanized steel 6 Concrete tile 9 ABS 12 None used (open hole)									
SCREEN OR PERFORATION OPENINGS ARE: 5 Gauzed wrapped 8 Saw cut 11 None (open hole)									
1 Continuous slot 3 Mill slot 6 Wire wrapped 9 Drilled holes									
2 Louvered shutter 4 Key punched 7 Torch cut 10 Other (specify) ft.									
SCREEN-PERFORATED INTERVALS: From ft. to ft., From ft. to ft.									
GRAVEL PACK INTERVALS: From ft. to ft., From ft. to ft.									
6 GROUT MATERIAL: 1 Neat cement 2 Cement grout 3 Bentonite 4 Other									
Grout Intervals: From ft. to ft., From ft. to ft., From ft. to ft.									
What is the nearest source of possible contamination: 10 Livestock pens 14 Abandoned water well									
1 Septic tank 4 Lateral lines 7 Pit privy 11 Fuel storage 15 Oil well/Gas well									
2 Sewer lines 5 Cess pool 8 Sewage lagoon 12 Fertilizer storage 16 Other (specify below)									
3 Watertight sewer lines 6 Seepage pit 9 Feedyard 13 Insecticide storage									
Direction from well? How many feet?									
FROM TO LITHOLOGIC LOG FROM TO PLUGGING INTERVALS									
Fl. mt manways were removed									
2" pvc pipe pulled & drilled out to TD-10'									
Well was plugged									
Bentonite from 10'-1'									
Drilling cuttings from cement from 1'-0'									
7 CONTRACTOR'S OR LANDOWNER'S CERTIFICATION: This water well was (1) constructed, (2) reconstructed, or (3) plugged under my jurisdiction and was completed on (mo/day/year) 4-22-00 and this record is true to the best of my knowledge and belief. Kansas									
Water Well Contractor's Licence No. 539 This Water Well Record was completed on (mo/day/yr) 4-25-00									
under the business name of JB Environemtnal Drilling by (signature) James Becker									
INSTRUCTIONS: Use typewriter or ball point pen. PLEASE PRESS FIRMLY and PRINT clearly. Please fill in blanks, underline or circle the correct answers. Send top three copies to Kansas Department of Health and Environment, Bureau of Water, Topeka, Kansas 66620-0001. Telephone 785-296-5524. Send one to WATER WELL OWNER and retain one for your records. Fee of \$5.00 for each constructed well.									