

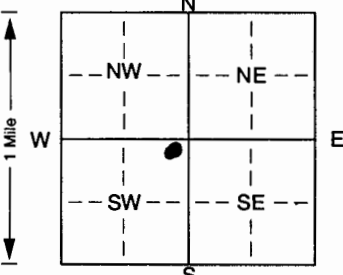
WATER WELL RECORD Form WWC-5 KSA 82a-1212 ID No.

1 LOCATION OF WATER WELL: Fraction NE ¼ NE ¼ SW ¼ Section Number 3 Township Number T 11 S Range Number R 25 E/W
 County: Wyandotte

Distance and direction from nearest town or city street address of well if located within city?
1400 N. 5th Street Kansas City, Ks.

2 WATER WELL OWNER: Unified Gov. of Wyandotte Co.
 RR#, St. Address, Box # : 701 N. 7th St.
 City, State, ZIP Code : Kansas City, Ks.

Board of Agriculture, Division of Water Resources
 Application Number:

3 LOCATE WELL'S LOCATION WITH AN "X" IN SECTION BOX:

 4 DEPTH OF COMPLETED WELL: 22' ft. ELEVATION:
 Depth(s) Groundwater Encountered 1.17' ft. 2. ft. 3. ft.
 WELL'S STATIC WATER LEVEL 16.15 ft. below land surface measured on mo/day/yr 6-1-00
 Pump test data: Well water was ft. after hours pumping gpm
 Est. Yield gpm; Well water was ft. after hours pumping gpm
 Bore Hole Diameter 8 1/2" in. to 22' ft., and in. to ft.
 WELL WATER TO BE USED AS: 5 Public water supply 8 Air conditioning 11 Injection well
 1 Domestic 3 Feedlot 6 Oil field water supply 9 Dewatering 12 Other (Specify below)
 2 Irrigation 4 Industrial 7 Domestic (lawn & garden) 10 Monitoring well
 Was a chemical/bacteriological sample submitted to Department? Yes No ; If yes, mo/day/yr sample was sub-
 mitted Water Well Disinfected? Yes No

5 TYPE OF BLANK CASING USED:
 1 Steel 2 PVC 3 RMP (SR) 4 ABS 5 Wrought iron 6 Asbestos-Cement 7 Fiberglass 8 Concrete tile 9 Other (specify below)
 Blank casing diameter 2.375 in. to 12' ft., Dia in. to ft., Dia in. to ft.
 Casing height above land surface Flush Mt. in., weight lbs./ft. Wall thickness or gauge No. SDR 13
 TYPE OF SCREEN OR PERFORATION MATERIAL: 7 PVC 10 Asbestos-cement SCH 40
 1 Steel 3 Stainless steel 5 Fiberglass 8 RMP (SR) 11 Other (specify)
 2 Brass 4 Galvanized steel 6 Concrete tile 9 ABS 12 None used (open hole)
 SCREEN OR PERFORATION OPENINGS ARE:
 1 Continuous slot 3 Mill slot 5 Gauzed wrapped 8 Saw cut 11 None (open hole)
 2 Louvered shutter 4 Key punched 6 Wire wrapped 9 Drilled holes
 7 Torch cut 10 Other (specify) ft.
 SCREEN-PERFORATED INTERVALS: From 22' ft. to 12' ft., From ft. to ft.
 From ft. to ft., From ft. to ft.
 GRAVEL PACK INTERVALS: From 22' ft. to 10' ft., From ft. to ft.
 From ft. to ft., From ft. to ft.

6 GROUT MATERIAL: 1 Neat cement 2 Cement grout 3 Bentonite 4 Other
 Grout Intervals: From 10' ft. to 3' ft., From 3' ft. to 0' ft., From ft. to ft.
 What is the nearest source of possible contamination:
 1 Septic tank 4 Lateral lines 7 Pit privy 10 Livestock pens 14 Abandoned water well
 2 Sewer lines 5 Cess pool 8 Sewage lagoon 11 Fuel storage 15 Oil well/Gas well
 3 Watertight sewer lines 6 Seepage pit 9 Feedyard 12 Fertilizer storage 16 Other (specify below)
 13 Insecticide storage
 Direction from well? East How many feet? 80'

FROM	TO	LITHOLOGIC LOG	FROM	TO	PLUGGING INTERVALS
0	22	Brn clay, firm, moist, some debris.			
		Dk brn mottled clay, firm-soft, mod. odor.			

F.H. OK'd by D. Taylor

7 CONTRACTOR'S OR LANDOWNER'S CERTIFICATION: This water well was (1) constructed (2) reconstructed, or (3) plugged under my jurisdiction and was completed on (mo/day/year) 5-30-00 and this record is true to the best of my knowledge and belief. Kansas Water Well Contractor's Licence No. 539 This Water Well Record was completed on (mo/day/yr) 10-4-00 under the business name of JB Environmental Drilling by (signature) James Bieber