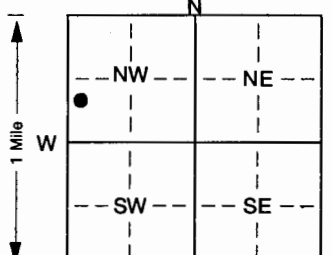


1) LOCATION OF WATER WELL: County: Wyandotte		Fraction: NW 1/4 SW 1/4 NW 1/4		Section Number: 2		Township Number: T 11		Range Number: S R 25		Elev: (E)W	
Distance and direction from nearest town or city street address of well if located within city? 1601 Fairfax Trfy. Kansas City, KS											
2) WATER WELL OWNER: Lady Baltimore Foods, Inc.											
RR#, St. Address, Box #: 1601 Fairfax Trfy.											
City, State, ZIP Code: Kansas City, Ks. 66115											
Board of Agriculture, Division of Water Resources Application Number:											
3) LOCATE WELL'S LOCATION WITH AN "X" IN SECTION BOX:				4) DEPTH OF COMPLETED WELL: 30' ft. ELEVATION: 24' ft.							
				Depth(s) Groundwater Encountered: 124' ft. 2. 24' ft. 3. 24' ft.							
				WELL'S STATIC WATER LEVEL: 20.91 ft. below land surface measured on mo/day/yr 6-19-00							
				Pump test data: Well water was _____ ft. after _____ hours pumping _____ gpm							
				Est. Yield _____ gpm; Well water was _____ ft. after _____ hours pumping _____ gpm							
				Bore Hole Diameter: 8 1/2" in. to 20' ft., and _____ in. to _____ ft.							
				WELL WATER TO BE USED AS: 5 Public water supply 8 Air conditioning 11 Injection well							
				1 Domestic 3 Feedlot 6 Oil field water supply 9 Dewatering 12 Other (Specify below)							
				2 Irrigation 4 Industrial 7 Domestic (lawn & garden) 10 Monitoring well							
				Was a chemical/bacteriological sample submitted to Department? Yes. _____ No. X ; If yes, mo/day/yr sample was submitted _____							
				Water Well Disinfected? Yes _____ No (X)							
5) TYPE OF BLANK CASING USED:											
1 Steel 3 RMP (SR) 5 Wrought iron 8 Concrete tile CASING JOINTS: Glued. _____ Clamped. _____											
2 PVC 4 ABS 6 Asbestos-Cement 9 Other (specify below) Welded. _____											
Blank casing diameter: 2.375 in. to 20' ft., Dia _____ in. to _____ ft., Dia _____ in. to SDR 13 ft.											
Casing height above land surface: Flush ft., weight _____ lbs./ft. Wall thickness or gauge No. SCH 40											
TYPE OF SCREEN OR PERFORATION MATERIAL:											
1 Steel 3 Stainless steel 5 Fiberglass 7 PVC 10 Asbestos-cement											
2 Brass 4 Galvanized steel 6 Concrete tile 8 RMP (SR) 11 Other (specify) _____											
9 ABS 12 None used (open hole)											
SCREEN OR PERFORATION OPENINGS ARE:											
1 Continuous slot 3 Mill slot 5 Gauzed wrapped 8 Saw cut 11 None (open hole)											
2 Louvered shutter 4 Key punched 6 Wire wrapped 9 Drilled holes											
7 Torch cut 10 Other (specify) _____ ft.											
SCREEN-PERFORATED INTERVALS: From 30' ft. to 20' ft., From _____ ft. to _____ ft.											
From 30' ft. to _____ ft., From _____ ft. to _____ ft.											
GRAVEL PACK INTERVALS: From 30' ft. to 18' ft., From _____ ft. to _____ ft.											
From _____ ft. to _____ ft., From _____ ft. to _____ ft.											
6) GROUT MATERIAL: 1 Neat cement 2 Cement grout 3 Bentonite 4 Other _____											
Grout Intervals: From 18' ft. to 3' ft., From 3' ft. to 0' ft., From _____ ft. to _____ ft.											
What is the nearest source of possible contamination:											
1 Septic tank 4 Lateral lines 7 Pit privy 11 Fuel storage 14 Abandoned water well											
2 Sewer lines 5 Cess pool 8 Sewage lagoon 12 Fertilizer storage 15 Oil well/Gas well											
3 Watertight sewer lines 6 Seepage pit 9 Feedyard 13 Insecticide storage 16 Other (specify below) _____											
Direction from well? Southeast How many feet? 40'											
FROM TO LITHOLOGIC LOG FROM TO PLUGGING INTERVALS											
0 1 Gravel											
1 5 Fine gr sand fill, some clay & gravel.											
5 10 fine gr sand, sub rounded, dry, no odor.											
10 20 Dk brn-blk gray sand, sub rounded, well sorted, no odor.											
20 30 Brn sand, sub rounded, well sorted, wet at 24', no odor.											
F1 mt ok'd by Don Taylor											
7) CONTRACTOR'S OR LANDOWNER'S CERTIFICATION: This water well was (1) constructed (2) reconstructed, or (3) plugged under my jurisdiction and was completed on (mo/day/year) 5-19-00 and this record is true to the best of my knowledge and belief. Kansas Water Well Contractor's Licence No. 539 This Water Well Record was completed on (mo/day/yr) 11-5-00 under the business name of JB Environmental Drilling by (signature) James Beebe											
INSTRUCTIONS: Use typewriter or ball point pen. PLEASE PRESS FIRMLY and PRINT clearly. Please fill in blanks, underline or circle the correct answers. Send top three copies to Kansas Department of Health and Environment, Bureau of Water, Topeka, Kansas 66620-0001. Telephone 785-296-5524. Send one to WATER WELL OWNER and retain one for your records. Fee of \$5.00 for each constructed well.											