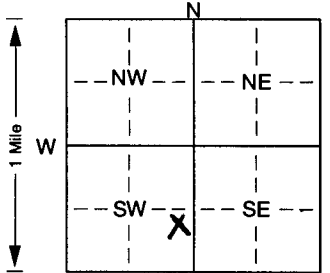


1] LOCATION OF WATER WELL:		Fraction	Pump WWC-3	RGR 02A-1212 1D NO.	Section Number	Township Number	Range Number
County: Wyandotte		NE ¼ SE ¼ SW ¼	27	T 11 S R 25 E			
Distance and direction from nearest town or city street address of well if located within city? 1122 Southwest Blvd, Kansas City, Kansas							
2] WATER WELL OWNER: McCall Service Stations RR#, St. Address, Box #: 8680 W 96th Street City, State, ZIP Code: Shawnee Mission KS 66212							
Board of Agriculture, Division of Water Resources Application Number:							
3] LOCATE WELL'S LOCATION WITH	4] DEPTH OF COMPLETED WELL: 17.0 ft. ELEVATION: 790.54						
AN "X" IN SECTION BOX: 		Depth(s) Groundwater Encountered 1. 11.0 ft. 2. — ft. 3. — ft. WELL'S STATIC WATER LEVEL 10.58 ft. below land surface measured on mo/day/yr 11-29-00 Pump test data: Well water was — ft. after — hours pumping — gpm Est. Yield — gpm; Well water was — ft. after — hours pumping — gpm Bore Hole Diameter 8 1/2 in. to 17.0 ft., and — in. to — ft. WELL WATER TO BE USED AS: 5 Public water supply 8 Air conditioning 11 Injection well 1 Domestic 3 Feedlot 6 Oil field water supply 9 Dewatering 12 Other (Specify below) 2 Irrigation 4 Industrial 7 Domestic (lawn & garden) 10 Monitoring well					
Was a chemical/bacteriological sample submitted to Department? Yes. No. X; If yes, mo/day/yrs sample was submitted Water Well Disinfected? Yes No X							
5] TYPE OF BLANK CASING USED: 1 Steel 3 RMP (SR) 5 Wrought iron 8 Concrete tile CASING JOINTS: Glued. Clamped. 2 PVC 4 ABS 6 Asbestos-Cement 9 Other (specify below) Welded Blank casing diameter 2 in. to 7 ft., Dia. — in. to — ft., Dia. — in. to — ft. Casing height above land surface 0 in., weight — lbs./ft. Wall thickness or gauge No. Sch 40 TYPE OF SCREEN OR PERFORATION MATERIAL: 1 Steel 3 Stainless steel 5 Fiberglass 7 PVC 10 Asbestos-cement 2 Brass 4 Galvanized steel 6 Concrete tile 8 RMP (SR) 11 Other (specify) SCREEN OR PERFORATION OPENINGS ARE: 1 Continuous slot 3 Mill slot 5 Gauzed wrapped 8 Saw cut 11 None (open hole) 2 Louvered shutter 4 Key punched 6 Wire wrapped 9 Drilled holes SCREEN-PERFORATED INTERVALS: From 7 ft. to 17 ft., From — ft. to — ft. GRAVEL PACK INTERVALS: From 5 ft. to 17 ft., From — ft. to — ft.							
6] GROUT MATERIAL: 1 Neat cement 2 Cement grout 3 Bentonite 4 Other Grout Interval 3 ft. to 5 ft., From 0 ft. to 0 ft., From — ft. to — ft. What is the nearest source of possible contamination: 1 Septic tank 4 Lateral lines 7 Pit privy 10 Livestock pens 14 Abandoned water well 2 Sewer lines 5 Cess pool 8 Sewage lagoon 11 Fuel storage 15 Oil well/Gas well 3 Watertight sewer lines 6 Seepage pit 9 Feedyard 12 Fertilizer storage 16 Other (specify below) Direction from well? How many feet?							
LITHOLOGIC LOG				PLUGGING INTERVALS			
FROM	TO		FROM	TO			
0	0.5	Asphalt					
0.5	7	Silt and gravel					
7	17	Clayey silt, greenish black					
7] CONTRACTOR'S OR LANDOWNER'S CERTIFICATION: This water well was (1) constructed, (2) reconstructed, or (3) plugged under my jurisdiction and was completed on (mo/day/year) 11/21/00 and this record is true to the best of my knowledge and belief. Kansas Water Well Contractor's Licence No. 656 This Water Well Record was completed on (mo/day/yr) 12/23/00 under the business name of Fleer and Associates Inc. by (signature) Charles Kasper							
INSTRUCTIONS: Use typewriter or ball point pen. PLEASE PRESS FIRMLY AND PRINT clearly. Please fill in blanks, underline or circle the correct answers. Send top three copies to Kansas Department of Health and Environment, Bureau of Water, Topeka, Kansas 66620-0001. Telephone 785-296-5524. Send one to WATER WELL OWNER and retain one for your records. Fee of \$5.00 for each constructed well.							