

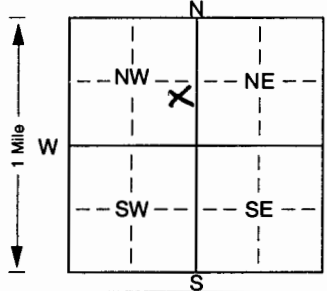
WYANDOTTE

WATER WELL RECORD

Form WWC-5

KSA 82a-1212 ID No.

MW#3

1 LOCATION OF WATER WELL:		Fraction	Section Number	Township Number		Range Number
County: <u>Wyandotte</u>		<u>NE 1/4 SE 1/4 NW 1/4</u>	<u>22</u>	T <u>11</u> S		R <u>25</u> <u>EN</u>
Distance and direction from nearest town or city street address of well if located within city? <u>835 South St. Paul, K.C. Ks</u> MW#3						
2 WATER WELL OWNER:						
RR#, St. Address, Box # : <u>Mr. Jeff Robertson</u>				Board of Agriculture, Division of Water Resources		
City, State, ZIP Code : <u>PO Box 5306 KC Ks 66119</u>				Application Number:		
3 LOCATE WELL'S LOCATION WITH		4 DEPTH OF COMPLETED WELL: <u>40</u> ft. ELEVATION:				
AN "X" IN SECTION BOX:		Depth(s) Groundwater Encountered 1. ft. 2. ft. 3. ft.				
		WELL'S STATIC WATER LEVEL ft. below land surface measured on mo/day/yr				
		Pump test data: Well water was ft. after hours pumping gpm				
		Est. Yield gpm: Well water was ft. after hours pumping gpm				
		Bore Hole Diameter: <u>7 1/4</u> in. to <u>40</u> ft., and in. to ft.				
		WELL WATER TO BE USED AS: 5 Public water supply 8 Air conditioning 11 Injection well				
		1 Domestic 3 Feedlot 6 Oil field water supply 9 Dewatering 12 Other (Specify below)				
		2 Irrigation 4 Industrial 7 Domestic (lawn & garden) <u>10</u> Monitoring well				
Was a chemical/bacteriological sample submitted to Department? Yes. No. <u>---</u> ; If yes, mo/day/yr sample was submitted						
Water Well Disinfected? Yes No						
5 TYPE OF BLANK CASING USED:						
1 Steel		3 RMP (SR)	5 Wrought iron	8 Concrete tile	CASING JOINTS: Glued. Clamped.	
<u>PVC</u>		4 ABS	6 Asbestos-Cement	9 Other (specify below)	Welded	
			7 Fiberglass		Threaded <u>X</u>	
Blank casing diameter <u>2</u> in. to <u>25</u> ft., Dia in. to ft., Dia in. to ft.						
Casing height above land surface <u>0</u> in., weight <u>Sched 40</u> lbs./ft. Wall thickness or gauge No.						
TYPE OF SCREEN OR PERFORATION MATERIAL:						
1 Steel		3 Stainless steel	5 Fiberglass	<u>PVC</u>	10 Asbestos-cement	
2 Brass		4 Galvanized steel	6 Concrete tile	8 RMP (SR)	11 Other (specify)	
				9 ABS	12 None used (open hole)	
SCREEN OR PERFORATION OPENINGS ARE:						
1 Continuous slot		<u>6</u> Mill slot <u>0.10</u>	5 Gauzed wrapped	8 Saw cut	11 None (open hole)	
2 Louvered shutter		4 Key punched	6 Wire wrapped	9 Drilled holes		
			7 Torch cut	10 Other (specify)	ft.	
SCREEN-PERFORATED INTERVALS: From <u>40</u> ft. to <u>25</u> ft., From ft. to ft.						
GRAVEL PACK INTERVALS: From <u>40</u> ft. to <u>23</u> ft., From ft. to ft.						
From ft. to ft., From ft. to ft.						
6 GROUT MATERIAL: 1 Neat cement 5 Cement grout <u>Bentonite</u> 4 Other						
Grout Intervals: From <u>20</u> ft. to ft., From <u>23</u> ft. to <u>20</u> ft., From ft. to ft.						
What is the nearest source of possible contamination:						
1 Septic tank		4 Lateral lines	7 Pit privy	10 Livestock pens	14 Abandoned water well	
2 Sewer lines		5 Cess pool	8 Sewage lagoon	11 Fuel storage	15 Oil well/Gas well	
3 Watertight sewer lines		6 Seepage pit	9 Feedyard	12 Fertilizer storage	16 Other (specify below)	
				13 Insecticide storage	<u>Form 11. UST</u>	
Direction from well? <u>NW</u> How many feet? <u>55</u>						
FROM	TO	LITHOLOGIC LOG	FROM	TO	PLUGGING INTERVALS	
<u>0</u>	<u>8"</u>	<u>Asphalt</u>				
<u>8"</u>	<u>3</u>	<u>Fill Material clay & rock</u>				
<u>3</u>	<u>11</u>	<u>Silty Brn Clay</u>				
<u>11</u>	<u>18</u>	<u>Silty clay & sand</u>				
<u>18</u>	<u>28</u>	<u>Fine to Med Sand</u>				
<u>28</u>	<u>40</u>	<u>Med to Coarse Sand</u>				
		<u>WET</u>				
7 CONTRACTOR'S OR LANDOWNER'S CERTIFICATION: This water well was <u>(1)</u> constructed, (2) reconstructed, or (3) plugged under my jurisdiction and was completed on (mo/day/year) <u>01-3-01</u> and this record is true to the best of my knowledge and belief. Kansas Water Well Contractor's Licence No. <u>575</u> This Water Well Record was completed on (mo/day/yr) <u>1-25-01</u> under the business name of <u>FUNKIE DRILLING SERVICE INC</u> by (signature) <u>[Signature]</u>						
INSTRUCTIONS: Use typewriter or ball point pen. PLEASE PRESS FIRMLY and PRINT clearly. Please fill in blanks, underline or circle the correct answers. Send top three copies to Kansas Department of Health and Environment, Bureau of Water, Topeka, Kansas 66620-0001. Telephone 785-296-5524. Send one to WATER WELL OWNER and retain one for your records. Fee of \$5.00 for each constructed well.						