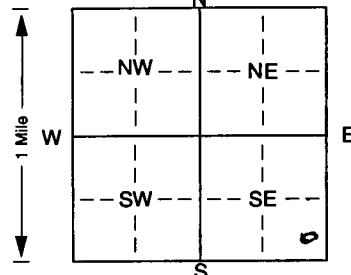


1 LOCATION OF WATER WELL:		Fraction	Section Number	Township Number	Range Number
County: <u>Wyandotte</u>		<u>SE 1/4 SE 1/4 SE 1/4</u>	<u>10</u>	T <u>11</u> S	R <u>25</u> <u>EW</u>
Distance and direction from nearest town or city street address of well if located within city? <u>In K.C.; Galamba Metal, 194 Renewal Rd, K.C. Ks.</u>					
2 WATER WELL OWNER:		Board of Agriculture, Division of Water Resources			
RR#, St. Address, Box # : <u>3005 Manchester</u>		Application Number:			
City, State, ZIP Code : <u>K.C. Ks. 64129</u>					
3 LOCATE WELL'S LOCATION WITH		4 DEPTH OF COMPLETED WELL			
AN "X" IN SECTION BOX:		ft. ELEVATION:			
		Depth(s) Groundwater Encountered <u>120</u> ft. 2. <u>120</u> ft. 3. <u>120</u> ft.			
		WELL'S STATIC WATER LEVEL <u>19.27</u> ft. below land surface measured on mo/day/yr <u>9-11-03</u>			
		Pump test data: Well water was _____ ft. after _____ hours pumping _____ gpm			
		Est. Yield _____ gpm Well water was _____ ft. after _____ hours pumping _____ gpm			
		Bore Hole Diameter <u>8 1/2</u> in. to <u>40</u> ft., and _____ in. to _____ ft.			
		WELL WATER TO BE USED AS: 5 Public water supply 8 Air conditioning 11 Injection well			
		1 Domestic 3 Feedlot 6 Oil field water supply 9 Dewatering 12 Other (Specify below)			
		2 Irrigation 4 Industrial 7 Domestic (lawn & garden) 10 Monitoring well			
		Was a chemical/bacteriological sample submitted to Department? Yes _____ No <u>X</u> ; If yes, mo/day/yr sample was submitted _____			
		Water Well Disinfected? Yes _____ No <u>(No)</u>			
5 TYPE OF BLANK CASING USED:					
1 Steel 3 RMP (SR) 5 Wrought iron 8 Concrete tile CASING JOINTS: Glued _____ Clamped _____					
2 PVC 4 ABS 6 Asbestos-Cement 9 Other (specify below) Welded <u>X</u>					
7 Fiberglass _____ Threaded <u>X</u>					
Blank casing diameter <u>2 3/8</u> in. to <u>22</u> ft., Dia _____ in. to _____ ft., Dia _____ in. to _____ ft.					
Casing height above land surface <u>2</u> in., weight _____ lbs./ft. Wall thickness or gauge No. <u>sch 40</u>					
TYPE OF SCREEN OR PERFORATION MATERIAL:					
1 Steel 3 Stainless steel 5 Fiberglass 7 PVC 10 Asbestos-cement					
2 Brass 4 Galvanized steel 6 Concrete tile 8 RMP (SR) 11 Other (specify) _____					
9 ABS 12 None used (open hole)					
SCREEN OR PERFORATION OPENINGS ARE:					
1 Continuous slot 3 Mill slot 5 Gauzed wrapped 8 Saw cut 11 None (open hole)					
2 Louvered shutter 4 Key punched 6 Wire wrapped 9 Drilled holes					
7 Torch cut 10 Other (specify) _____					
SCREEN-PERFORATED INTERVALS: From <u>40</u> ft. to <u>20</u> ft., From _____ ft. to _____ ft.					
GRAVEL PACK INTERVALS: From <u>40</u> ft. to <u>18</u> ft., From _____ ft. to _____ ft.					
20 From _____ ft. to _____ ft.					
21 From _____ ft. to _____ ft.					
515 From _____ ft. to _____ ft.</					