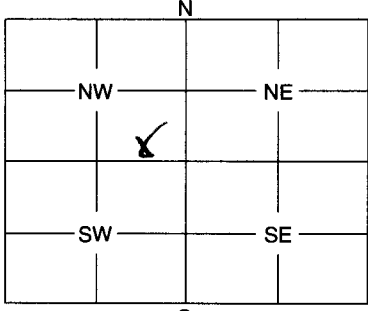


1 LOCATION OF WATER WELL: Fraction SW SE NW NW Section Number 2 Township Number 11 S Range Number 25 EW  
 County: Wyandotte  
 Distance and direction from nearest town or city street address of well if located within city?

2029 Fairfax KS KS 66115

2 WATER WELL OWNER: Conoco Phillips Company  
 RR #, St. Address, Box #: 1218 Phillips Bldg 420 Skecker Ave  
 City, State, ZIP Code: Wichita KS 67204 Board of Agriculture, Division of Water Resources  
 Application Number: \_\_\_\_\_

3 MARK WELL'S LOCATION WITH AN "X" IN SECTION BOX:  
  
 N  
 NW NE  
 W X E  
 SW SE  
 S

4 DEPTH OF WELL 25.31 ft.  
 WELL'S STATIC WATER LEVEL \_\_\_\_\_ ft.  
 WELL WAS USED AS:  
 1 Domestic 5 Public Water Supply 9 Dewatering  
 2 Irrigation 6 Oil Field Water Supply 10 Monitoring Well  
 3 Feedlot 7 Domestic (Lawn & Garden) 11 Injection Well  
 4 Industrial 8 Air Conditioning 12 Other \_\_\_\_\_  
 Was a chemical / bacteriological sample submitted to Department? Yes \_\_\_\_\_ No 8  
 If yes, mo/day/yr sample was submitted \_\_\_\_\_  
 Water Well Disinfected: Yes \_\_\_\_\_ No 1

5 TYPE OF BLANK CASING USED:  
 1 Steel 3 RMP (SR) 5 Wrought 7 Fiberglass 9 Other (Specify below)  
2 PVC 4 ABS 6 Asbestos-Cement 8 Concrete Tile \_\_\_\_\_  
 Blank casing diameter 2 in. Was casing pulled? Yes 1 No \_\_\_\_\_ If yes, how much 14  
 Casing height above or below land surface 29 in.

6 GROUT PLUG MATERIAL: 1 Neat cement 2 Cement grout 3 Bentonite 4 Other \_\_\_\_\_  
 Grout Plug Intervals: From 25.31 ft. to 0 ft., From \_\_\_\_\_ ft. to \_\_\_\_\_ ft., From \_\_\_\_\_ ft. to \_\_\_\_\_ ft.  
 What is the nearest source of possible contamination:  
 1 Septic tank 6 Seepage pit 11 Fuel storage 16 Other (specify below)  
 2 Sewer lines 7 Pit privy 12 Fertilizer storage  
 3 Watertight sewer lines 8 Sewage lagoon 13 Insecticide storage  
 4 Lateral lines 9 Feedyard 14 Abandoned water well  
 5 Cess pool 10 Livestock pens 15 Oil well/Gas well  
 Direction from well? \_\_\_\_\_ How many feet? \_\_\_\_\_

FROM	TO	PLUGGING MATERIALS
<u>25.31</u>	<u>0</u>	<u>Cement Grout</u>

7 CONTRACTOR'S OF LANDOWNER'S CERTIFICATION: This water well was plugged under my jurisdiction and was completed on (mo/day/year) 10-29-89 and this record is true to the best of my knowledge and belief. Kansas Water Well Contractor's License No. 704 This Water Well Record was completed on (mo/day/year) 2-11-85 under the business name of MAXS  
 by (signature) David Humphrey

INSTRUCTIONS: Use typewriter or ball point pen. Please press firmly and print clearly. Please fill in blanks, underline or circle the correct answers. Send top three copies to Kansas Department of Health and Environment, Bureau of Water, Geology Section, 1000 SW Jackson St., Ste. 420, Topeka, Kansas 66612-1367. Telephone: 785/296-5522. Send one to Water Well Owner and retain one for your records.

File Name:	Created By:	Date Created:	 CH2M HILL
XX	E. MOLANDER	JUNE 2005	