

CORRECTION(S) TO WATER WELL RECORD (WWC-5)

(to rectify lacking or incorrect information)

County: Wyandotte

Location listed as:

Section-Township-Range: 22-50N-33WFraction ($\frac{1}{4}$ $\frac{1}{4}$ $\frac{1}{4}$): NW NW SW

Location changed to:

2-11S-25ESW SW NW

Other changes: Initial statements: _____

Changed to: _____

Comments: _____

verification method: Well address, city street map, andKansas City 1:24,000 topo. map.initials: DRG date: 4/18/2005

submitted by: Kansas Geological Survey, Data Resources Library, 1930 Constant Ave., Lawrence, KS 66047-3726

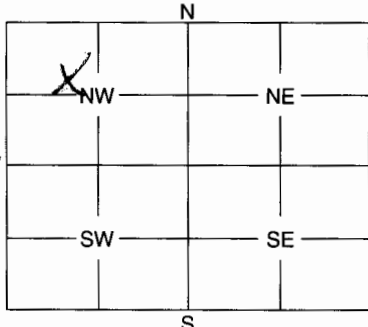
to: Kansas Dept of Health & Environment, Bureau of Water, 1000 SW Jackson, Suite 420, Topeka, KS 66612-1367.

MW 203

1	LOCATION OF WATER WELL:	Fraction	Section	Number	Township	Number	Range	Number
	County: <u>Wyandotte</u>	<u>N 1/4 NW 1/4 SE 1/4</u>	<u>22</u>		<u>GN</u>		<u>33</u>	<u>EW</u>

Distance and direction from nearest town or city street address of well if located within city?
2029 Fairfax KCKS 66115

2	WATER WELL OWNER: <u>CONOCO Phillips Company</u>	Board of Agriculture, Division of Water Resources
	RR #, St. Address, Box #: <u>B18 Phillips Bldg 420 S Becker Ave</u>	Application Number: _____
	City, State, ZIP Code: <u>Bartlesville OK 74004</u>	

3	MARK WELL'S LOCATION WITH AN "X" IN SECTION BOX:	4	DEPTH OF WELL <u>25.12</u> ft.
		WELL'S STATIC WATER LEVEL _____ ft. WELL WAS USED AS: 1 Domestic 5 Public Water Supply 9 Dewatering 2 Irrigation 6 Oil Field Water Supply 10 Monitoring Well 3 Feedlot 7 Domestic (Lawn & Garden) 11 Injection Well 4 Industrial 8 Air Conditioning 12 Other _____	
Was a chemical / bacteriological sample submitted to Department? Yes _____ No <u>2</u> If yes, mo/day/yr sample was submitted _____ Water Well Disinfected: Yes _____ No <u>X</u>			

5	TYPE OF BLANK CASING USED:			
	1 Steel	3 RMP (SR)	5 Wrought	7 Fiberglass
	2 PVC	4 ABS	6 Asbestos-Cement	8 Concrete Tile
	9 Other (Specify below) _____			
	Blank casing diameter <u>2</u> in. Was casing pulled? Yes <u>X</u> No _____ If yes, how much <u>44</u>			
	Casing height above or below land surface <u>25.12</u> in.			

6	GROUT PLUG MATERIAL: 1 Neat cement 2 Cement grout 3 Bentonite 4 Other _____			
	Grout Plug Intervals: From <u>25.12</u> ft. to <u>0</u> ft., From _____ ft. to _____ ft., From _____ to _____ ft.			
	What is the nearest source of possible contamination:			
	1 Septic tank	6 Seepage pit	11 Fuel storage	16 Other (specify below) _____
	2 Sewer lines	7 Pit privy	12 Fertilizer storage	
	3 Watertight sewer lines	8 Sewage lagoon	13 Insecticide storage	
	4 Lateral lines	9 Feedyard	14 Abandoned water well	
	5 Cess pool	10 Livestock pens	15 Oil well/Gas well	
	Direction from well? _____ How many feet? _____			

FROM	TO	PLUGGING MATERIALS
<u>25.12</u>	<u>0</u>	<u>Cement Grout</u>

7	CONTRACTOR'S OF LANDOWNERS CERTIFICATION: This water well was plugged under my jurisdiction and was completed on (mo/day/year) <u>12-2-04</u> and this record is true to the best of my knowledge and belief. Kansas Water Well Contractor's License No. <u>704</u> This Water Well Record was completed on (mo/day/year) <u>2-11-05</u> under the business name of <u>MAX</u>
	by (signature) <u>David Hume</u>

INSTRUCTIONS: Use typewriter or ball point pen. Please press firmly and print clearly. Please fill in blanks, underline or circle the correct answers. Send top three copies to Kansas Department of Health and Environment, Bureau of Water, Geology Section, 1000 SW Jackson St., Ste. 420, Topeka, Kansas 66612-1367. Telephone: 785/296-5522. Send one to Water Well Owner and retain one for your records.