

MW01-8

## WATER WELL PLUGGING RECORD

FORM WWC-5P

KSA 82a-1212

1 LOCATION OF WATER WELL:	Fraction	Section Number	Township Number	Range Number
County: <b>Wyandotte</b>	<b>NE ¼ NW ¼ NW ¼</b>	<b>19</b>	<b>11</b>	<b>25 E</b>

Distance and direction from nearest town or city street address of well if located within city?

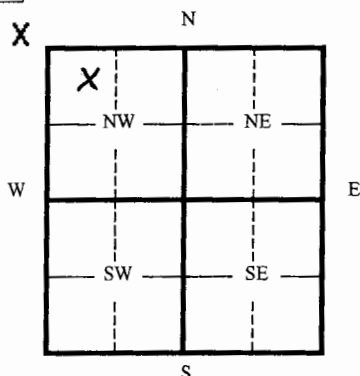
**Argentine Railyard, Argentine, Kansas**2 WATER WELL OWNER: **Burlington Northern Railway Co.**RR#, St. Address, Box # **4515 Kansas Avenue**

Board of Agriculture, Division of Water Resources

City, State, ZIP Code : **Kansas City, Kansas 66106**

Application Number:

3 MARK WELL'S LOCATION WITH AN "X" IN SECTION BOX:

4 DEPTH OF WELL **65** ft.WELL'S STATIC WATER LEVEL **Unknown** ft.

WELL WAS USED AS:

- |              |                              |  |
|--------------|------------------------------|--|
| 1 Domestic   | 5 Public Water Supply        | 9 Dewatering   |
| 2 Irrigation | 6 Oil Field Water Supply     | <input checked="" type="checkbox"/> 10 Monitoring Well |
| 3 Feedlot    | 7 Lawn and Garden (domestic) | 11 Injection Well                                      |
| 4 Industrial | 8 Air Conditioning           | 12 Other   |

Was a chemical/bacteriological sample submitted to Department? Yes No ☒

If yes, mo/day/yr sample was submitted

Water Well Disinfected: Yes No ☒

5 TYPE OF BLANK CASING USED:

- |   |            |                   |                 |                         |
|---|------------|-------------------|-----------------|-------------------------|
| 1 Steel                                   | 3 RMP (SR) | 5 Wrought         | 7 Fiberglass    | 9 Other (specify below) |
| <input checked="" type="checkbox"/> 2 PVC | 4 ABC      | 6 Asbestos-Cement | 8 Concrete Tile |                         |

Blank casing diameter **2** in. Was casing pulled? Yes ☒ No If yes, how much **10** ft.Casing height above or below land surface **120** in.6 GROUT PLUG MATERIAL: 1 Neat cement 2 Cement grout ☒ 3 Bentonite 4 OtherGrout Plug Intervals From **10** ft. to **65** ft. From ft. to ft. From ft. to ft.

What is the nearest source of possible contamination:

- |                          |                   |   |                          |
|--------------------------|-------------------|---|--------------------------|
| 1 Septic tank            | 6 Seepage pit     | <input checked="" type="checkbox"/> 11 Fuel storage | 16 Other (specify below) |
| 2 Sewer lines            | 7 Pit privy       | 12 Fertilizer storage                               |                          |
| 3 Watertight sewer lines | 8 Sewage lagoon   | 13 Insecticide storage                              |                          |
| 4 Lateral lines          | 9 Feedyard        | 14 Abandoned water well                             |                          |
| 5 Cess Pool              | 10 Livestock pens | 15 Oil well/ Gas well                               |                          |

Direction from well? **Unknown**

How many feet? \_\_\_\_\_

FROM	TO	CODE	PLUGGING MATERIALS
0	10		Compacted soil as the result of excavation to remove pump hung up in casing
10	65		Bentonite

7 CONTRACTOR'S OR LANDOWNER'S CERTIFICATION: This water well was plugged under my jurisdiction and was completed on (mo/day/yr) **1/14/05** and this record is true to the best of my knowledge and belief. Kansas Water Well Contractor's License No. **616** This Water Well Record was completed on (mo/day/yr) **4/11/05** under the business name of **Thiele Geotech, Inc.** by (signature) *D. J. Al*

INSTRUCTIONS: Please fill in blanks and circle the correct answers. Send three copies to Kansas Department of Health and Environment, Bureau of Water, Topeka, Kansas 66620-0001. Telephone: 785-296-3565. Send one to Water Well Owner and retain one for your records.