

CORRECTION(S) TO WATER WELL RECORD (WWC-5)

(to rectify lacking or incorrect information)

Location listed as:

Section-Township-Range: None Given

Fraction ($\frac{1}{4}$ $\frac{1}{4}$ $\frac{1}{4}$): _____

County: Wyandotte

Location changed to:

21-115-25E

NW NW NW

Other changes: Initial statements: _____

Changed to: _____

Comments: _____

verification method: Well owner's address, city street map, and

Shawnee 1:24,000 topo. map.

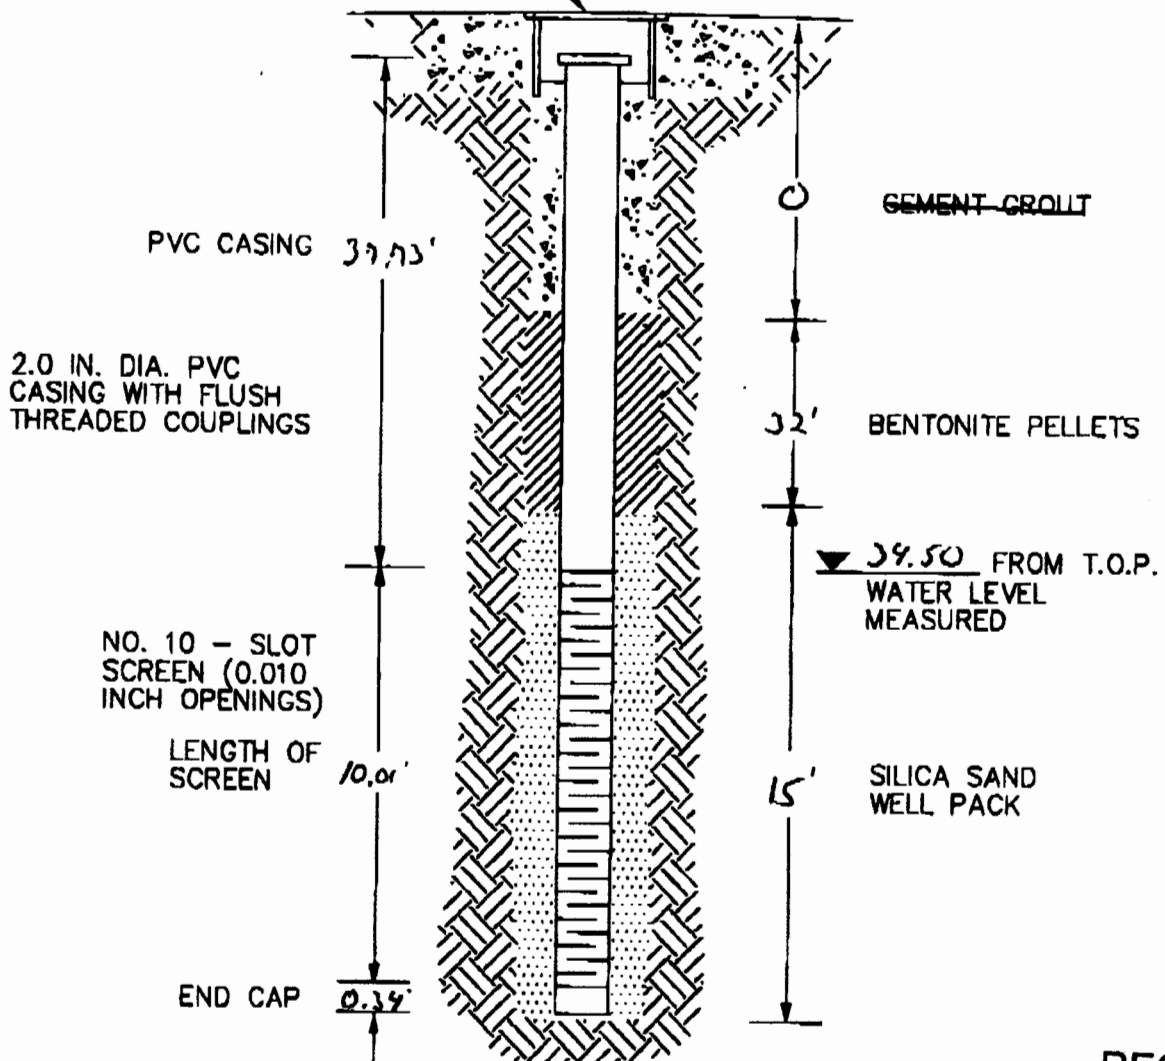
initials: ORL date: 7/1/2005

submitted by: Kansas Geological Survey, Data Resources Library, 1930 Constant Ave., Lawrence, KS 66047-3726

to: Kansas Dept of Health & Environment, Bureau of Water, 1000 SW Jackson, Suite 420, Topeka, KS 66612-1367.

1 LOCATION OF WATER WELL:		Fraction	Section Number	Township Number	Range Number
County:		1/4 1/4 1/4		T S	R E/W
Distance and direction from nearest town or city street address of well if located within city?					
2 WATER WELL OWNER: The PQ Corporation RR#, St. Address, Box # : 1700 Kansas Ave. City, State, ZIP Code : Kansas City, KS Board of Agriculture, Division of Water Resources Application Number:					
3 LOCATE WELL'S LOCATION WITH AN "X" IN SECTION BOX:		4 DEPTH OF COMPLETED WELL 48 ft. ELEVATION:			
<div style="text-align:center">N -NW--NE-- -SW--SE-- S W E</div>		Depth(s) Groundwater Encountered 1 ft. 2 ft. 3 ft.			
		WELL'S STATIC WATER LEVEL 34.5 ft. below land surface measured on mo/day/yr			
		Pump test data: Well water was ft. after hours pumping gpm			
		Est. Yield gpm: Well water was ft. after hours pumping gpm			
		WELL WATER TO BE USED AS: 1 Domestic 3 Feedlot 6 Oil field water supply 9 Dewatering 12 Other (Specify below) 2 Irrigation 4 Industrial 7 Domestic (lawn & garden) 10 Monitoring well			
		Was a chemical/bacteriological sample submitted to Department? Yes No X; If yes, mo/day/yr sample was submitted Water Well Disinfected? Yes No			
5 TYPE OF BLANK CASING USED: 1 Steel 3 RMP (SR) 5 Wrought iron 8 Concrete tile CASING JOINTS: Glued Clamped 2 PVC 4 ABS 6 Asbestos-Cement 9 Other (specify below) Welded Blank casing diameter 2 in. to 38 ft., Dia in. to ft., Dia in. to ft. Casing height above land surface 0 in., weight lbs./ft. Wall thickness or gauge No. Sch 40 TYPE OF SCREEN OR PERFORATION MATERIAL: 1 Steel 3 Stainless Steel 5 Fiberglass 7 PVC 10 Asbestos-Cement 2 Brass 4 Galvanized Steel 6 Concrete tile 8 RMP (SR) 11 Other (Specify) SCREEN OR PERFORATION OPENINGS ARE: 1 Continuous slot 3 Mill slot 5 Guazed wrapped 8 Saw cut 11 None (open hole) 2 Louvered shutter 4 Key punched 6 Wire wrapped 9 Drilled holes SCREEN-PERFORATED INTERVALS: From 38 ft. to 48 ft., From ft. to ft. GRAVEL PACK INTERVALS: From 33 ft. to 48 ft., From ft. to ft.					
6 GROUT MATERIAL: 1 Neat cement 2 Cement grout 3 Bentonite 4 Other Grout Intervals: From 0 ft. to 2 ft., From ft. to ft., From ft. to ft. What is the nearest source of possible contamination: 1 Septic tank 4 Lateral lines 7 Pit privy 10 Livestock pens 14 Abandoned water well 2 Sewer lines 5 Cess pool 8 Sewage lagoon 11 Fuel storage 15 Oil well/Gas well 3 Watertight sewer lines 6 Seepage pit 9 Feedyard 12 Fertilizer storage 16 Other (specify below) Direction from well? How many feet?					
FROM	TO	LITHOLOGIC LOG	FROM	TO	PLUGGING INTERVALS
See attached					
7 CONTRACTOR'S OR LANDOWNER'S CERTIFICATION: This water well was (1) constructed, (2) reconstructed, or (3) plugged under my jurisdiction and was completed on (mo/day/year) 5-17-95 and this record is true to the best of my knowledge and belief. Kansas Water Well Contractor's Licence No 759 This Water Well Record was completed on (mo/day/yr) 6-6-95 under the business name of RAZEK Environmental, LLC by signature Anthony J. Paulsen					

STEEL PROTECTIVE COVER

SURFACE
ELEVATION 755.2
TOP OF PIPE (T.O.P.)
ELEVATION 755.4

DATE INSTALLED

5/17/05

RECEIVED

JUN 21 2005

BUREAU OF WATER

BOTTOM OF
WELL
BELOW GRADE
48.08

NOT TO SCALE

Burns &
McDonnell

CONSTRUCTION DIAGRAM

MW-9

Drilling Log

Project Name PA		Project Number 3527 3527		Boring Number ML-9						
Ground Elevation 755.7		Location KLK		Page 1						
Air Monitoring Equipment LEL/O₂				Total Footage 50						
Drilling Type	Hole Size	Overburden Footage	Bedrock Footage	No. of Samples	No. of Core Boxes					
HSA	8"	50'	NA	0	NA					
Drilling Company Razak			Driller(s) Tony Razak, Vincent Ryan							
Drilling Rig Geo Probe 6620 DT			Type of Sampler NA							
Date 5/17/05		To 5/17/05		Field Observer(s) NATHAN KILGORE						
Depth (feet)	Description	Class	Blow Count	Recov.	Run/ Time	Sample Desig.	PID (ppm)			Remarks/ Water Levels
							BZ	BH	S	
1	Gravel fill, brick, silty clay, black (7.5YR2.5) trace plasticity. Soft consistency, moist	NA	NA	NA						
2										
3	Silt-sand clay, black (7.5YR2.5) med plasticity. Soft consistency, moist									
4										
5	brown (7.5YR5/2)									
6										
7										
8										
9										
10										
11										
12	Sand, fine clay, dark brown (4.5YR2.5) subrounded, well sorted, med grain wet									
13	Seam									
14	dry moist									

RECEIVED
JUN 21 2005
BUREAU OF WATER

Drilling Log Continuation

Project Name <u>PQ</u>							Boring Number			
Project Number <u>39278</u>							Page <u>2</u>			
Date <u>5/12/05</u>										
Depth (feet)	Description	Class	Blow Count	Recov.	Run/ Time	Sample Desig.	PID (ppm)			Remarks/ Water Levels
							BZ	BH	S	
15	Sand somewhat dark brown (1.5% R/S) Subsided, well sorted, med. grain (S) Wet seam									
16										
17										
RECEIVED
JUN 21 2005
BUREAU OF WATER

Drilling Log Continuation

Project Name PQ						Boring Number				
Project Number 31527 39278						Page 3				
						Date 5/17/05				
Depth (feet)	Description	Class	Blow Count	Recov.	Run/ Time	Sample Desig.	PID (ppm)			Remarks/ Water Levels
							BZ	BM	S	
33	Sand, brown (7.54x 1/2) subrounded well sorted, med. sh. med. to st									
34										
35										
36										
37										
38										
39										
40										
41										
42										
43										
44										
45										
46										
47										
48										
49										

RECEIVED
JUN 21 2005
BUREAU OF WATER

Set well @
48'