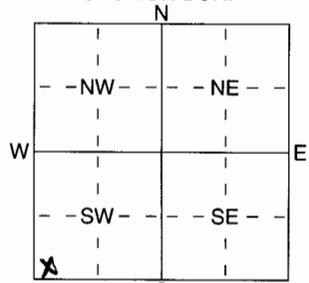


1 LOCATION OF WATER WELL: County: Wyandotte Fraction: SE 1/4 SE 1/4 SW 1/4 Section Number: 34 Township Number: T 11 S Range Number: R 25 EW

Distance and direction from nearest town or city street address of well if located within city?
4612 Mission Rd., Kansas City, Kansas MW-1R

2 WATER WELL OWNER: Rivera Station
 RR#, St. Address, Box #: 4612 Mission Rd. Board of Agriculture, Division of Water Resources
 City, State, ZIP Code: Kansas City, Kansas 64103 Application Number:

3 LOCATE WELL'S LOCATION WITH AN "X" IN SECTION BOX:

 4 DEPTH OF COMPLETED WELL: 7 ft. ELEVATION: _____ ft.
 Depth(s) Groundwater Encountered: 1 _____ ft. 2 _____ ft. 3 _____ ft.
 WELL'S STATIC WATER LEVEL: 4.34 ft. below land surface measured on mo/day/yr 5-2-05
 Pump test data: Well water was _____ ft. after _____ hours pumping _____ gpm
 Est. Yield _____ gpm: Well water was _____ ft. after _____ hours pumping _____ gpm
 WELL WATER TO BE USED AS:
 1 Domestic 3 Feedlot 6 Oil field water supply 9 Dewatering 12 Other (Specify below)
 2 Irrigation 4 Industrial 7 Domestic (lawn & garden) Monitoring well

5 TYPE OF BLANK CASING USED:
 1 Steel 3 RMP (SR) 5 Wrought iron 8 Concrete tile CASING JOINTS: Glued _____ Clamped _____
 2 PVC 4 ABS 6 Asbestos-Cement 9 Other (specify below) Welded _____
 7 Fiberglass _____ Threaded _____
 Blank casing diameter: 2 in. to 4 ft., Dia _____ in. to _____ ft., Dia _____ in. to _____ ft.
 Casing height above land surface: 0 in., weight _____ lbs./ft. Wall thickness or gauge No. _____
 TYPE OF SCREEN OR PERFORATION MATERIAL:
 1 Steel 3 Stainless Steel 5 Fiberglass 8 RMP (SR) 10 Asbestos-Cement
 2 Brass 4 Galvanized Steel 6 Concrete tile 9 ABS 12 None used (open hole)
 SCREEN OR PERFORATION OPENINGS ARE:
 1 Continuous slot 2 Mill slot 5 Gauzed wrapped 8 Saw cut 11 None (open hole)
 2 Louvered shutter 4 Key punched 6 Wire wrapped 9 Drilled holes
 7 Torch cut 10 Other (specify) _____ ft.
 SCREEN-PERFORATED INTERVALS: From 7 ft. to 14 ft., From _____ ft. to _____ ft.
 GRAVEL PACK INTERVALS: From 3 ft. to 14 ft., From _____ ft. to _____ ft.

6 GROUT MATERIAL: 1 Neat cement 2 Cement grout 3 Bentonite 4 Other Concrete 0-2'
 Grout Intervals: From 2 ft. to 3 ft., From _____ ft. to _____ ft., From _____ ft. to _____ ft.
 What is the nearest source of possible contamination:
 1 Septic tank 4 Lateral lines 7 Pit privy 10 Livestock pens 14 Abandoned water well
 2 Sewer lines 5 Cess pool 8 Sewage lagoon 11 Fuel storage 15 Oil well/Gas well
 3 Watertight sewer lines 6 Seepage pit 9 Feedyard 12 Fertilizer storage 16 Other (specify below)
 Direction from well? _____ How many feet? _____

FROM	TO	LITHOLOGIC LOG	FROM	TO	PLUGGING INTERVALS
0	1	Gravel			
4'	10'	sand w/ clay, grey, v. moist, petroleum odor			Flushmount wavier by D. Taylor
9'	11'	sand, very wet			
11'	14'	clay @ 13.5', brown-red-brown, v. wet			

7 CONTRACTOR'S OR LANDOWNER'S CERTIFICATION: This water well was (1) constructed, (2) reconstructed, or (3) plugged under my jurisdiction and was completed on (mo/day/year) 4/28/05 and this record is true to the best of my knowledge and belief. Kansas Water Well Contractor's Licence No 157 This Water Well Record was completed on (mo/day/yr) 5-16-05 under the business name of Larsen & Associates, Inc. by (signature) Kathy Mann

Riveria

4/28/05

Tom Winn Onsite

MSA tube used for field screening
mmR

0-11 -

Gravel (no sample)

4-6 400

Sand w/ clay, ^{DR}gray, very moist, petro odor.

9-11

Sand - no sample, very wet

14 TO

Clay @ ~13.5' brn - red brn,
~~the~~ wet

0-4 Riser

0-2 Concrete

4-14 Screen

2-3 Seal

3-14 Sand